

MISSISSIPPI DEPARTMENT OF NATURAL RESOURCES

Bureau of Land and Water Resources

Southport Mall

P.O. Box 10631

Jackson, Mississippi 39209

WATER WELL DRILLERS LOG

Paul River
T 200

3-18-83 19 Walker Welding Paul River
date well completed firm name county well located

| LANDOWNER | description of formations encountered | from | to |
|----------------------|---------------------------------------|-----------|-----------|
| <u>Ed. Puente</u> | | | |
| <u>Picayune Miss</u> | <u>Yung shell</u> | <u>0</u> | <u>18</u> |
| (mailing address) | <u>Sand gravel</u> | <u>18</u> | <u>42</u> |

WELL LOCATION:
sec 35 T 5 N R 18
S W W
6 miles W of Picayune
(distance) (direction) (nearest town)

WELL PURPOSE: Home
(home, irrigation, municipal, industrial)

- WELL COMPLETION DATA:
- (1) diameter (inches) 2"
 - (2) total depth (feet) 42'
 - (3) static water level (feet) 14 below above top of ground.
 - (4) casing PVC 42
(material) (depth)
 - (size) if telescope see back.
 - (5) screen 10' 32'
(length) (depth to top)
 - 12 PVC
(size) (material)
 - (6) pump 1/2 10
(HP) (yield gpm)
 - Electric
(type power)
 - (7) electric log (yes or no) _____
 - (organization running log) _____
 - (8) how well bottom plugged Sand
shock

DRILLERS REMARKS:


DEPT. OF NATURAL RESOURCES
BUREAU OF LAND & WATER RESOURCES

APR - 4 1983

RECEIVED

If well telescopes please
sketch and show depths.

GROUND LEVEL

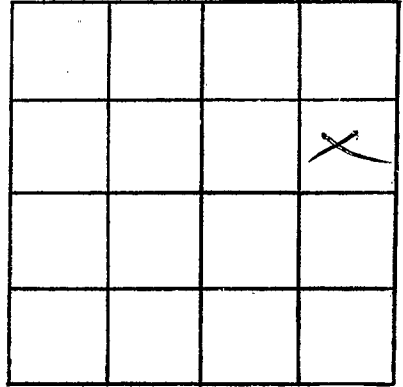

SECTION _____

Please indicate well location X.

ADDITIONAL INFORMATION

If more than one screen,
show locations of each on sketch.