

MISSISSIPPI DEPARTMENT OF NATURAL RESOURCES

Bureau of Land and Water Resources

Southport Mall

P.O. Box 10631

Jackson, Mississippi 39209

WATER WELL DRILLERS LOG

Pearl River  
T 2022

June 9 1983 Walker Well Drilling Pearl River  
 date well completed firm name county well located

LANDOWNER:	description of formations encountered	from	to
<u>Sawney Haddox</u>			
<u>Picayune Miss</u> (mailing address)	<u>Red shale</u>	<u>0</u>	<u>12</u>
	<u>sand</u>	<u>12</u>	<u>18</u>
	<u>Blue shale</u>	<u>18</u>	<u>48</u>
	<u>sand pine ground</u>	<u>48</u>	<u>60</u>
WELL LOCATION:			
sec <u>33</u> T <u>5</u> N R <u>18</u> S			
<u>3</u> miles <u>NW</u> of <u>Picayune</u>			
(distance) (direction) (nearest town)			
WELL PURPOSE: <u>Home</u>			
(home, irrigation, municipal, industrial)			
WELL COMPLETION DATA:			
(1) diameter (inches) <u>2"</u>			
(2) total depth (feet) <u>60'</u>			
(3) static water level (feet) <u>12</u> below top of ground.			
(4) casing <u>PVC</u> , <u>50'</u> (material) (depth)			
(size) If telescope see back.			
(5) screen <u>10'</u> , <u>50'</u> (length) (depth to top)			
<u>12</u> , <u>PVC</u> (size) (material)			
(6) pump <u>1</u> , <u>8</u> (HP) (yield gpm)			
<u>Elec</u> (type power)			
(7) electric log (yes or no)			
(organization running log)			
(8) how well bottom plugged <u>Sand</u> <u>shale</u>			
DRILLERS REMARKS:			


DEPT. OF NATURAL RESOURCES  
 BUREAU OF LAND & WATER RESOURCES

JUN 14 1983

RECEIVED

If well telescopes please sketch and show depths.

GROUND LEVEL

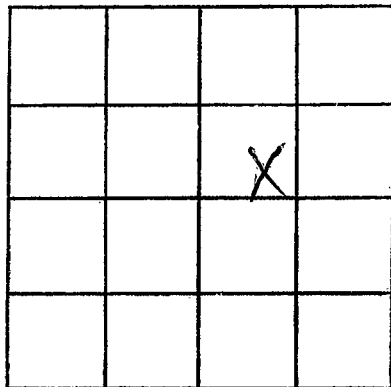

SECTION \_\_\_\_\_

Please indicate well location X.

ADDITIONAL INFORMATION

If more than one screen,  
show locations of each on sketch.