

Pearl River
T 2003

MISSISSIPPI DEPARTMENT OF NATURAL RESOURCES
 Bureau of Land and Water Resources
 Southport Mall
 P.O. Box 10631
 Jackson, Mississippi 39209
WATER WELL DRILLERS LOG

9-15-83 19 Walker's Welding and Repair Pearl River
 date well completed firm name county well located

LANDOWNER:
Timothy Dodd
Shirley Drive
Picayune Ms
 (mailing address)

description of formations encountered	from	to
<u>Red Clay</u>	<u>0</u>	<u>5</u>
<u>Fine Sand</u>	<u>5</u>	<u>20</u>
<u>Coarse Sand</u>	<u>20</u>	<u>50</u>

WELL LOCATION:
 sec. 30 T. 518 N. R. 18 E
7 miles NW of Picayune
 (distance) (direction) (nearest town)

WELL PURPOSE: Home
 (home, irrigation, municipal, industrial)

- WELL COMPLETION DATA:**
- (1) diameter (inches) 2"
 - (2) total depth (feet) 50
 - (3) static water level (feet) 10 below ~~above~~ top of ground.
 - (4) casing PVC, 10 (depth),
 (material) (size) If telescope see back.
 - (5) screen 10', 10 (length), (depth to top)
12 (size), PVC (material)
 - (6) pump 1/2 (HP), 8 (yield gpm)
Electric (type power)
 - (7) electric log no (yes or no)
 (organization running log)
 - (8) how well bottom plugged Sand Shark

DRILLERS REMARKS:


DEPT. OF NATURAL RESOURCES
 BUREAU OF LAND & WATER RESOURCES

OCT 14 1983

RECEIVED

If well telescopes please sketch and show depths.

GROUND LEVEL

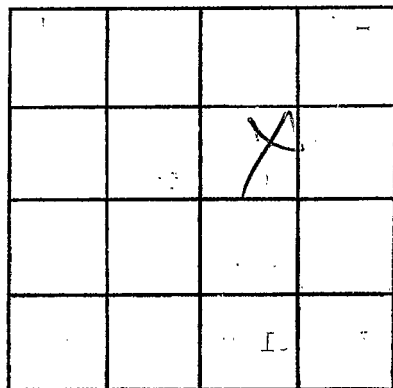

SECTION _____

Please indicate well location X.

ADDITIONAL INFORMATION

If more than one screen,
show locations of each on sketch.