

MISSISSIPPI DEPARTMENT OF NATURAL RESOURCES

Bureau of Land and Water Resources

Southport Mall

P.O. Box 10631

Jackson, Mississippi 39209

WATER WELL DRILLERS LOG

Pearl River
T2024

May 2 1984 Walker Welding Pearl River
date well completed firm name county well located

LANDOWNER:	description of formations encountered	from	to
<u>Larry Weeks</u>			
<u>Carnie Miss</u>			
<u>R.T. 1</u> (mailing address)	<u>Redshale</u>	<u>0</u>	<u>18</u>
	<u>sand gravel</u>	<u>18</u>	<u>90</u>
WELL LOCATION:			
sec. <u>3</u> T <u>5</u> S R <u>18</u> W			
<u>15</u> miles <u>NW</u> <u>Picayune</u>			
(distance) (direction) (nearest town)			
WELL PURPOSE: <u>Home</u> (home, irrigation, municipal, industrial)			
WELL COMPLETION DATA:			
(1) diameter (inches) <u>2"</u>			
(2) total depth (feet) <u>90'</u>			
(3) static water level (feet) <u>18</u> below top of ground.			
(4) casing <u>PVC</u> <u>80'</u> (material) (depth)			
(size) if telescope see back.			
(5) screen <u>10</u> <u>80'</u> (length) (depth to top)			
<u>10</u> <u>PVC</u> (size) (material)			
(6) pump <u>1</u> <u>11</u> (HP) (yield gpm)			
<u>Electric</u> (type power)			
(7) electric log (yes or no) _____			
(organization running log) _____			
(8) how well bottom plugged <u>S.S.</u>			

DEPT. OF NATURAL RESOURCES
BUREAU OF LAND & WATER RESOURCES


MAY 11 1984

RECEIVED

DRILLERS REMARKS:

If well telescopes please sketch and show depths.

GROUND LEVEL

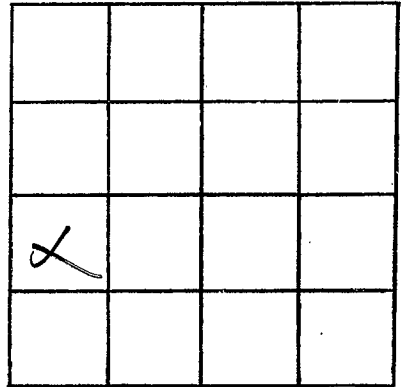

SECTION _____

Please indicate well location X.

ADDITIONAL INFORMATION

If more than one screen, show locations of each on sketch.