

MISSISSIPPI DEPARTMENT OF NATURAL RESOURCES

Bureau of Land and Water Resources

Southport Mall

P.O. Box 10631

Jackson, Mississippi 39209

WATER WELL DRILLERS LOG

Pearl River  
T 2025

June 12-84 date well completed  
Walkers Welding firm name  
Pearl River county well located

LANDOWNER	description of formations encountered	from	to
Jenny Loupe New Orleans La (mailing address)			
	Dray shell	0	12
	Hard lignum	12	30
<b>WELL LOCATION:</b>			
sec. <u>15</u> T. <u>5</u> N R. <u>18</u> W S W			
<u>14</u> miles <u>NW</u> of <u>Picayune</u> (distance) (direction) (nearest town)			
<b>WELL PURPOSE:</b> <u>Flow</u> (home, irrigation, municipal, industrial)			
<b>WELL COMPLETION DATA:</b>			
(1) diameter (inches) <u>2"</u>			
(2) total depth (feet) <u>30'</u>			
(3) static water level (feet) <u>12</u> below above top of ground.			
(4) casing <u>PVC</u> , <u>20'</u> (material) (depth)			
(size) if telescope see back.			
(5) screen <u>10'</u> , <u>20'</u> (length) (depth to top)			
<u>10</u> , <u>PVC</u> (size) (material)			
(6) pump <u>1/2</u> , <u>10</u> (HP) (yield gpm)			
<u>Elm</u> (type power)			
(7) electric log (yes or no) _____			
(organization running log) _____			
(8) how well bottom plugged <u>SS</u>			
DRILLERS REMARKS: _____			


DEPT. OF NATURAL RESOURCES  
BUREAU OF LAND & WATER RESOURCES

JUN 18 1984

RECEIVED

If well telescopes please sketch and show depths.

GROUND LEVEL

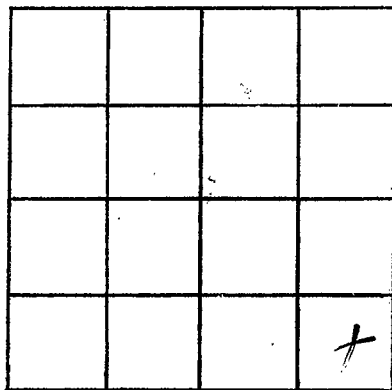

SECTION \_\_\_\_\_

Please indicate well location X.

ADDITIONAL INFORMATION

If more than one screen,  
show locations of each on sketch.