

**MISSISSIPPI DEPARTMENT OF NATURAL RESOURCES**  
 Bureau of Land and Water Resources  
 Southport Mall  
 P.O. Box 10631  
 Jackson, Mississippi 39209  
**WATER WELL DRILLERS LOG**

Pearl River  
Tosco

Feb. 3 19 86 Walker Welding Pearl River  
 date well completed firm name county well located

**LANDOWNER:**  
 John Sheffer Rt. 2 Picayune

description of formations encountered

from to

(mailing address)

**WELL LOCATION:**

sec. 12 5 T N R 18 E  
 5 miles NW of Picayune  
 (distance) (direction) (nearest town)

**WELL PURPOSE:** home  
 (home, irrigation, municipal, industrial)

**WELL COMPLETION DATA:**

- (1) diameter (inches) 4"
- (2) total depth (feet) 65'
- (3) static water level (feet) 10' below top of ground.
- (4) casing PVC 55'  
 (material) (depth)  
 (size) if telescope see back.
- (5) screen 10' 55'  
 (length) (depth to top)  
 10 PVC  
 (size) (material)
- (6) pump NO  
 (HP) (yield gpm)  
 (type power)
- (7) electric log (yes or no)  
 (organization running log)
- (8) how well bottom plugged  
 Sand Shark

Clay	0	10
Sand	10	16
Clay	16	35
Sand	35	65


**DRILLERS REMARKS:**

**RECEIVED**  
 FEB 26 1986

Department of Natural Resources  
 Bureau of Land & Water Resources

If well telescopes please sketch and show depths.

GROUND LEVEL

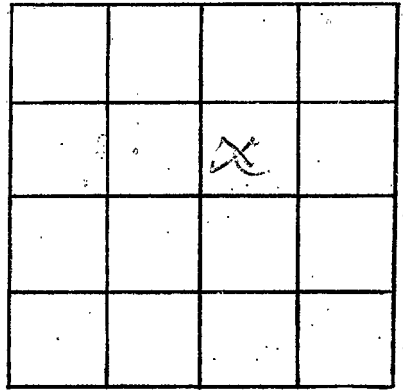

SECTION \_\_\_\_\_

Please indicate well location X.

ADDITIONAL INFORMATION

If more than one screen,  
show locations of each on sketch.