

Pearl River
Toolt

MISSISSIPPI DEPARTMENT OF NATURAL RESOURCES
Bureau of Land and Water Resources
Southport Mall
P.O. Box 10631
Jackson, Mississippi 39209
WATER WELL DRILLERS LOG

April 22 1986 Walkers Welding Pearl River
date well completed firm name county well located

LANDOWNER: Jim Sabel
Rt. 1 Picayune
(mailing address)

description of formations encountered	from	to
Clay	0	14
Sand	14	54

WELL LOCATION:
sec. 29 T 5 N R 18 E
3 miles NW of Picayune
(distance) (direction) (nearest town)

WELL PURPOSE: Home
(home, irrigation, municipal, industrial)

WELL COMPLETION DATA:

(1) diameter (inches) 2"

(2) total depth (feet) 54'

(3) static water level (feet) 15' below above
top of ground.

(4) casing PVC 44'
(material) (depth)
 If telescope see back.
(size)

(5) screen 10' 44'
(length) (depth to top)
#10 PVC
(size) (material)


(6) pump
(HP) (yield gpm)

(type power)

(7) electric log
(yes or no)

(organization running log)

(8) how well bottom plugged Sand Shark

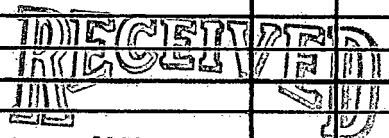

MAY 20 1986

Department of Natural Resources
Bureau of Land & Water Resources

DRILLERS REMARKS:

If well telescopes please sketch and show depths.

GROUND LEVEL

			(/)

SECTION _____

Please indicate well location X.

ADDITIONAL INFORMATION

If more than one screen,
show locations of each on sketch.