

MISSISSIPPI DEPARTMENT OF NATURAL RESOURCES

Bureau of Land and Water Resources

Southport Mall

P.O. Box 10631

Jackson, Mississippi 39209

RUD RINTON & SONS
WATER WELL DRILLERS LOG

Water Well Service

Rt. 4, Box 402

Pearl River

Warrens, Mississippi 39426

county well located

Phone 601-798-5324

PEARL RIVER
T203D

5-13 1986
date well completed

LANDOWNER: L.M. BOSS

119 Clark St. Picayune
Miss.

(mailing address)

description of formations encountered

from

to

<u>Red shale</u>	<u>0</u>	<u>12</u>
<u>White Sand</u>	<u>12</u>	<u>45</u>
<u>Blue shale</u>	<u>45</u>	<u>160</u>
<u>Blue sand</u>	<u>160</u>	<u>195</u>

WELL LOCATION:

sec. 24 T 5 N R 18 E
S W
3 miles W of Picayune
(distance) (direction) (nearest town)

WELL PURPOSE: home
(home, irrigation, municipal, industrial)

WELL COMPLETION DATA:

- (1) diameter (inches) 2 1/2
- (2) total depth (feet) 195
- (3) static water level (feet) 12 below above top of ground.
- (4) casing PVC, 195,
(material) (depth)
(size) if telescope see back.
- (5) screen 10, 185,
(length) (depth to top)
12, PVC
(size) (material)
- (6) pump 1, 1660,
(HP) (yield gpm)
Elect
(type power)
- (7) electric log no
(yes or no)

(organization running log)


(8) how well bottom plugged Hard

DRILLERS REMARKS:

RECEIVED
MAY 30 1986
DEPARTMENT OF NATURAL RESOURCES
BUREAU OF LAND & WATER

If well telescopes please sketch and show depths.

GROUND LEVEL

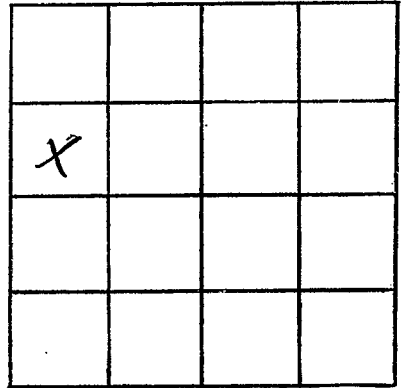

SECTION _____

Please indicate well location X.

ADDITIONAL INFORMATION

A series of horizontal lines for writing additional information, starting below the 'ADDITIONAL INFORMATION' header and extending to the bottom of the page.

If more than one screen, show locations of each on sketch.