

MISSISSIPPI DEPARTMENT OF NATURAL RESOURCES

Bureau of Land and Water Resources

Southport Mall

P.O. Box 10631

Jackson, Mississippi 39209

WATER WELL DRILLERS LOG

PEARL RIVER  
T-2031

5-31 1986 PENTON WELL SERV. PEARL RIVER  
date well completed firm name county well located

LANDOWNER: Bobby Robbins  
P.O. Box 15 Nicholson,  
MS. 39463  
(mailing address)

description of formations encountered	from	to
<u>CLAY</u>	<u>0</u>	<u>15</u>
<u>SAND &amp; GRAVEL</u>	<u>15</u>	<u>75</u>
<u>CLAY</u>	<u>75</u>	<u>270</u>
<u>SAND</u>	<u>270</u>	<u>367</u>

WELL LOCATION:  
sec. 35 T. 5 S. R. 18 E  
3 miles W of PICAYUNE  
(distance) (direction) (nearest town)

WELL PURPOSE: HOME  
(home, irrigation, municipal, industrial)

- WELL COMPLETION DATA:
- (1) diameter (inches) 2"
  - (2) total depth (feet) 367'
  - (3) static water level (feet) 11' below above top of ground.
  - (4) casing PVC 357'  
(material) (depth)  
2 if telescope see back.  
(size)
  - (5) screen 10' 357'  
(length) (depth to top)  
2" PVC  
(size) (material)
  - (6) pump 3/4  
(HP) (yield gpm)  
Elec  
(type power)
  - (7) electric log No  
(yes or no)  
  
(organization running log)
  - (8) how well bottom plugged BW


**RECEIVED**  
**JUN 25 1986**

DRILLERS REMARKS:

Department of Natural Resources  
Bureau of Land & Water Resources

If well telescopes please sketch and show depths.

GROUND LEVEL

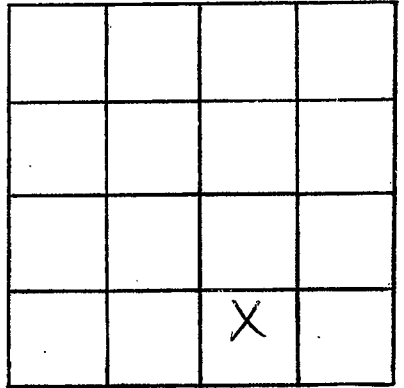

SECTION \_\_\_\_\_

Please indicate well location X.

ADDITIONAL INFORMATION

If more than one screen,  
show locations of each on sketch.