

MISSISSIPPI DEPARTMENT OF NATURAL RESOURCES

Bureau of Land and Water Resources

Southport Mall

P.O. Box 10631

Jackson, Mississippi 39209

WATER WELL DRILLERS LOG

PEARL RIVER
T 2032

6-1-86

19

86

Walkers Welding

Pearl river

date well completed

firm name

county well located

LANDOWNER: Tom Tozzie

description of formations encountered

from

to

Rt 2 Pigeonne

Clay

0

10

(mailing address)

Gravle

10

68

WELL LOCATION:

Blue Clay

68

205

sec. 29 T 5 N R 18 E

Sand

205

325

10 miles W of Pigeonne
(distance) (direction) (nearest town)

WELL PURPOSE: None
(home, irrigation, municipal, industrial)

WELL COMPLETION DATA:

- (1) diameter (inches) 2 1/2
- (2) total depth (feet) 322' 325'
- (3) static water level (feet) 10' below top of ground.

- (4) casing PVC 315'
(material) (depth)
 if telescope see back.
(size)

- (5) screen 10' 325'
(length) (depth to top)
315' PVC
(size) (material)

- (6) pump T 5gpm
(HP) (yield gpm)


(type power)

- (7) electric log
(yes or no)

(organization running log)

- (8) how well bottom plugged Sand Shrek

DRILLERS REMARKS:

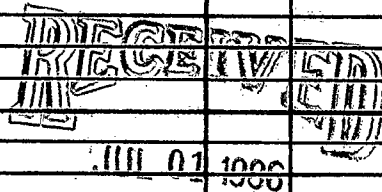


01 1986

Department of Natural Resources
Bureau of Land and Water Resources

If well telescopes please sketch and show depths.

GROUND LEVEL

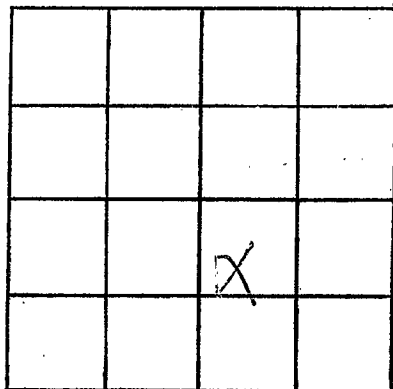

SECTION _____

Please indicate well location X.

ADDITIONAL INFORMATION

If more than one screen, show locations of each on sketch.