

MISSISSIPPI DEPARTMENT OF NATURAL RESOURCES

Bureau of Land and Water Resources

P.O. Box 10631

Jackson, Mississippi 39209

WATER WELL DRILLERS LOG

COUNTY WELL LOCATED
PEARL RIVER

WELL NUMBER
T 2034

CODED

DATE WELL COMPLETED
10-14-86

PERMIT NUMBER
0929

NAME OF DRILLING FIRM
Walker Well Drilling

NAME & MAILING ADDRESS OF LANDOWNER
Kathleen Williams

WELL LOCATION: SEC **26** TOWNSHIP **5** RANGE **N 18 E**

DISTANCE **2.0** Miles DIRECTION **NW** of NEAREST TOWN **PICAYUNE**

OTHER LANDMARK

WELL PURPOSE: Home, Irrigation, Municipal, Industrial, Fish Pond, etc.
home

PUMP DATA

PUMP TYPE (Circle One):
Submersible, Turbine, Jet, Flowing Well,
Other (Describe) **no pump**

POWER TYPE (Circle One):
Electric, Tractor, Diesel, Gasoline, Butane,
Other (Describe)

Pump Capacity (GPM) No. of Stages Setting Depth FT.

PUMP TEST
Well yielded _____ GPM with
a drawdown of _____ ft.
after _____ hours of pumping

WELL DATA

Well Depth 40'	Casing Diameter (In.) 2'	Casing Length (Ft.) 30'
Type of Casing PVC	Hole Depth 50'	Depth to Static Water Level 10'

TYPE OF COMPLETION: (Circle One or More):
Gravel Packed, Underreamed, Telescoped,
Natural Development, Open Hole, Other
(Describe) **air**

Top of Lap Pipe or Reduction in Casing
FEET IF TELESCOPED OR MORE THAN ONE SCREEN: USE BACK PAGE

LOG DATA

TYPE OF LOG RUN (Circle One): No Log Run, Electric, Gamma Ray, Density, Sonic, Neutron, Other (Describe)

Name of Organization Running Log

SCREEN DATA

Diameter - Inches 2'	Length - Feet 10	Slot Size - Inches 10
Screen Type Slot	Depth to Bottom - Feet 40'	

GEOLOGIC DATA (Office Use Only)

Surface Elev.	Geologic Unit	Unit Thickness	Depth to Top
Subs. SWL	Date	Analysis	Aquifer Test

Driller's Remarks


RECEIVED

DESCRIPTION OF FORMATIONS ENCOUNTERED	FROM	TO	FORMATIONS (Continued)	FROM	TO
BLACK DIRT	0	10	NOV 20 1986 Department of Natural Resources Bureau of Land & Water Resources		
SAND	10	20			
SAND & GRAVEL	20	40			

IF MORE SPACE IS NEEDED, USE BACK

If well telescopes please
sketch and show depths.

GROUND LEVEL

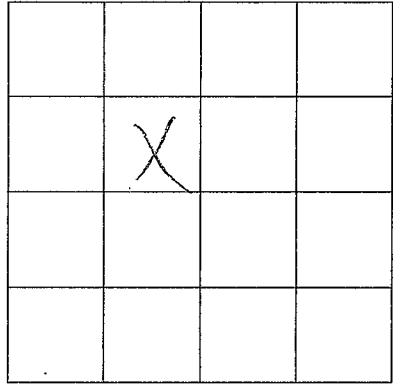

SECTION _____

Please indicate well location X.

ADDITIONAL INFORMATION

If more than one screen,
show location of each on sketch.