

MISSISSIPPI DEPARTMENT OF NATURAL RESOURCES

Bureau of Land and Water Resources

Southport Mall

P.O. Box 10631

Jackson, Mississippi 39209

WATER WELL DRILLERS LOG

Deane L. ...
 T 2039

1 19 *87 Sue Barton* *Pearl River*
 date well completed firm name county well located

LANDOWNER: *Ermond Martin*
B-T-1 Carrier's
3906
 (mailing address)

description of formations encountered	from	to
	<i>Red shale</i>	<i>0</i>
<i>Blue shale</i>	<i>70</i>	<i>160</i>
<i>10 ft. sand</i>	<i>160</i>	<i>195</i>

WELL LOCATION:
 sec. *39* T. *5* N R. *18* E
8 miles *West* of *Carrier*
 (distance) (direction) (nearest town)

WELL PURPOSE: *Home*
 (home, irrigation, municipal, industrial)

WELL COMPLETION DATA:

- (1) diameter (inches) 2
- (2) total depth (feet) 195
- (3) static water level (feet) 101 below above top of ground.
- (4) casing PVC, 195,
 (material) (depth)
 (size) if telescope see back.
- (5) screen 10, 185,
 (length) (depth to top)
12, PVC
 (size) (material)
- (6) pump 1, 360,
 (HP) (yield gpm)
Elect.
 (type power)
- (7) electric log NO
 (yes or no)
- (organization running log)
- (8) how well bottom plugged hard
shale

RECEIVED


JUN 12 1997

Department of Natural Resources
 Bureau of Land & Water Resources

DRILLERS REMARKS:

If well telescopes please sketch and show depths.

GROUND LEVEL

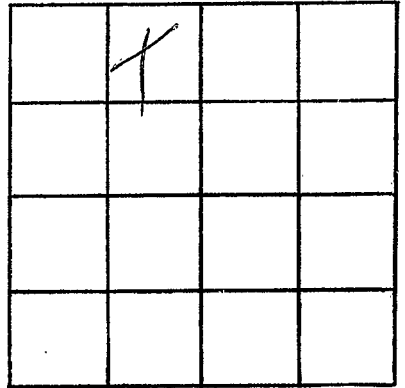

SECTION _____

Please indicate well location X.

ADDITIONAL INFORMATION

If more than one screen, show locations of each on sketch.