

MISSISSIPPI DEPARTMENT OF NATURAL RESOURCES

Bureau of Land and Water Resources

P.O. Box 10631
Jackson, Mississippi 39209
WATER WELL DRILLERS LOG

COUNTY WELL LOCATED
Wentz River

WELL NUMBER
T 0040

CODED

DATE WELL COMPLETED
MAY 26-87

PERMIT NUMBER
0428

NAME OF DRILLING FIRM
WALKER WELL DRILLING

NAME & MAILING ADDRESS OF LANDOWNER
Harvey E Kappes
1818 King's Row
Sudwell Ex. 70461

WELL LOCATION: SEC TOWNSHIP RANGE
14 5 N 18 E

DISTANCE DIRECTION NEAREST TOWN
10 Miles SW of Pritchard

OTHER LANDMARK

WELL PURPOSE Home Irrigation, Municipal, Industrial, Fish Pond, etc.

PUMP DATA

PUMP TYPE (Circle One):
Submersible, Turbine, Jet, Flowing Well, Other (Describe)

POWER TYPE (Circle One):
 Electric, Tractor, Diesel, Gasoline, Butane, Other (Describe)

Pump Capacity (GPM) No. of Stages Setting Depth
8 1 25 FT.

PUMP TEST

Well yielded _____ GPM with a drawdown of _____ ft. after _____ hours of pumping

WELL DATA

Well Depth <u>72'</u>	Casing Diameter (In.) <u>2"</u>	Casing Length (Ft.) <u>62"</u>
Type of Casing <u>PVC</u>	Hole Depth <u>72'</u>	Depth to Static Water Level <u>10'</u>

TYPE OF COMPLETION: (Circle One or More):
 Gravel Packed, Underreamed, Telescoped, Natural Development, Open Hole, Other
AIR

Top of Lap Pipe or Reduction in Casing

FEET IF TELESCOPED OR MORE THAN ONE SCREEN: USE BACK PAGE

LOG DATA

TYPE OF LOG RUN (Circle One):
 No Log Run, Electric, Gamma Ray, Density, Sonic, Neutron, Other (Describe)

Name of Organization Running Log

SCREEN DATA

Diameter - Inches <u>2"</u>	Length - Feet <u>10'</u>	Slot Size - Inches <u>#10</u>
Screen Type <u>SLOT</u>	Depth to Bottom - Feet <u>72"</u>	

GEOLOGIC DATA (Office Use Only)

Surface Elev.	Geologic Unit	Unit Thickness	Depth to Top
Subs. SWL	Date	Analysis	Aquifer Test

DESCRIPTION OF FORMATIONS ENCOUNTERED	FROM	TO
<u>BLACK OIL</u>	<u>0</u>	<u>10</u>
<u>SAND</u>	<u>10</u>	<u>20</u>
<u>GRAVEL</u>	<u>20</u>	<u>72</u>

Driller's Remarks

RECEIVED

FORMATIONS (Continued)	FROM	TO


AUG 03 1987

Department of Natural Resources
Bureau of Land & Water Resources

IF MORE SPACE IS NEEDED, USE BACK

If well telescopes please sketch and show depths.

GROUND LEVEL

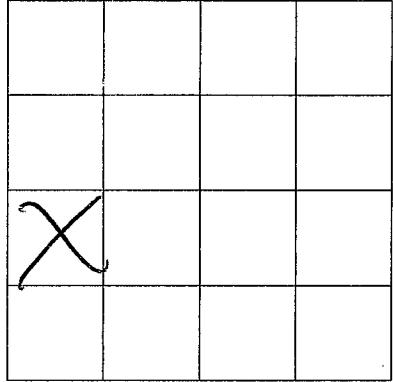

SECTION _____

Please indicate well location X.

ADDITIONAL INFORMATION

If more than one screen,
show location of each on sketch.