

MISSISSIPPI DEPARTMENT OF NATURAL RESOURCES

Bureau of Land and Water Resources

P.O. Box 10631

Jackson, Mississippi 39209

WATER WELL DRILLERS LOG

COUNTY WELL LOCATED PEARL RIVER	
WELL NUMBER T-2043	CODED
DATE WELL COMPLETED 12-28-87	

PERMIT NUMBER 0428
NAME OF DRILLING FIRM WALKER'S WELL SERVICE

NAME & MAILING ADDRESS OF LANDOWNER OGDEN-BARLETTO Box 2 Picayune, MS			
WELL LOCATION: SEC	TOWNSHIP	RANGE	
23	5	N 18 E	
DISTANCE	DIRECTION	NEAREST TOWN	
10 Miles	SW	of PICAYUNE	
OTHER LANDMARK CIBER			
WELL PURPOSE: <input checked="" type="checkbox"/> Home Irrigation, <input type="checkbox"/> Municipal, <input type="checkbox"/> Industrial, <input type="checkbox"/> Fish Pond, etc.			

PUMP DATA		
PUMP TYPE (Circle One): Submersible, Turbine, <input checked="" type="radio"/> Jet, Flowing Well, Other (Describe) Shallow well pump		
POWER TYPE (Circle One): Electric, Tractor, Diesel, Gasoline, Butane, Other (Describe)		
Pump Capacity (GPM) 8	No. of Stages 1	Setting Depth 25' FT.
PUMP TEST Well yielded _____ GPM with a drawdown of _____ ft. after _____ hours of pumping		

WELL DATA		
Well Depth 54'	Casing Diameter (In.) 2"	Casing Length (Ft.) 44'
Type of Casing PVC	Hole Depth 55'	Depth to Static Water Level 10'
TYPE OF COMPLETION: (Circle One or More): Gravel Packed, Underreamed, Telescoped, Natural Development, Open Hole, Other (Describe) AIR		
Top of Lap Pipe or Reduction in Casing _____ FEET <input type="checkbox"/> IF TELESCOPED OR MORE THAN ONE SCREEN: USE BACK PAGE		

LOG DATA	
TYPE OF LOG RUN (Circle One): No Log Run, Electric, Gamma Ray, Density, Sonic, Neutron, Other (Describe)	
Name of Organization Running Log	


SCREEN DATA		
Diameter - Inches 2"	Length - Feet 10	Slot Size - Inches #10
Screen Type SLOT	Depth to Bottom - Feet 54'	

GEOLOGIC DATA (Office Use Only)			
Surface Elev.	Geologic Unit	Unit Thickness	Depth to Top
Subs. SWL	Date	Analysis	Aquifer Test
Driller's Remarks			
RECEIVED			

DESCRIPTION OF FORMATIONS ENCOUNTERED	FROM	TO	FORMATIONS (Continued)	FROM	TO
CLAY	0	10			
SAWD	10	54'	Department of Natural Resources	005	
ROCKS	20	54'	Bureau of Land & Water Resources	003	
IF MORE SPACE IS NEEDED, USE BACK					

If well telescopes please sketch and show depths.

GROUND LEVEL

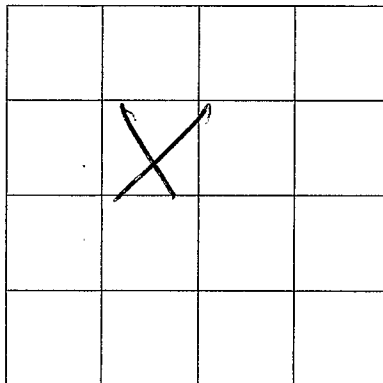

SECTION _____

Please indicate well location X.

ADDITIONAL INFORMATION

If more than one screen,
show location of each on sketch.