

# MISSISSIPPI DEPARTMENT OF NATURAL RESOURCES

Bureau of Land and Water Resources

P.O. Box 10631  
Jackson, Mississippi 39209  
WATER WELL DRILLERS LOG

COUNTY WELL LOCATED <b>REAL RIVER</b>	
WELL NUMBER <b>T 2045</b>	CODED
DATE WELL COMPLETED <b>6/15/88</b>	

PERMIT NUMBER <b>0428</b>
NAME OF DRILLING FIRM <b>WALKER WELL SERVICE</b>

NAME & MAILING ADDRESS OF LANDOWNER <b>James RAULS</b>		
<b>WALKER BLUFF</b>		
<b>Route 2 Piquemine</b>		
WELL LOCATION: SEC	TOWNSHIP	RANGE
<b>28</b>	<b>5</b>	<b>N 18 E</b>
DISTANCE	DIRECTION	NEAREST TOWN
<b>10</b> Miles	<b>S</b>	<b>Piquemine</b>
OTHER LANDMARK		
WELL PURPOSE: <input checked="" type="checkbox"/> Home, <input type="checkbox"/> Irrigation, <input type="checkbox"/> Municipal, <input type="checkbox"/> Industrial, <input type="checkbox"/> Fish Pond, etc.		


PUMP DATA		
PUMP TYPE (Circle One): Submersible, Turbine, Jet, <input type="checkbox"/> Flowing Well, Other (Describe) _____		
POWER TYPE (Circle One): Electric, Tractor, Diesel, Gasoline, Butane, Other (Describe) _____		
Pump Capacity (GPM)	No. of Stages	Setting Depth  <b>FT.</b>
PUMP TEST Well yielded <u><b>8</b></u> GPM with a drawdown of _____ ft. after _____ hours of pumping		

WELL DATA		
Well Depth <b>330'</b>	Casing Diameter (In.) <b>2"</b>	Casing Length (Ft.) <b>326'</b>
Type of Casing <b>PVC</b>	Hole Depth <b>336'</b>	Depth to Static Water Level <b>5'</b>
TYPE OF COMPLETION: (Circle One or More): Gravel Packed, Underreamed, Telescoped, Natural Development, Open Hole, Other (Describe) _____		
Top of Lap Pipe or Reduction in Casing <b>FEET</b> IF TELESCOPED OR MORE THAN ONE SCREEN: USE BACK PAGE		

LOG DATA	
TYPE OF LOG RUN (Circle One): No Log Run, Electric, Gamma Ray, Density, Sonic, Neutron, Other (Describe) _____	
Name of Organization Running Log	

SCREEN DATA		
Diameter - Inches <b>2"</b>	Length - Feet <b>10'</b>	Slot Size - Inches <b>#70</b>
Screen Type <b>SLOT</b>	Depth to Bottom - Feet <b>330'</b>	

GEOLOGIC DATA (Office Use Only)			
Surface Elev.	Geologic Unit	Unit Thickness	Depth to Top
Subs. SWL	Date	Analysis	Aquifer Test
Driller's Remarks			

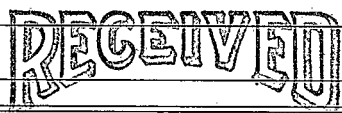


DESCRIPTION OF FORMATIONS ENCOUNTERED	FROM	TO	FORMATIONS (Continued)	FROM	TO
<b>CLAY</b>	<b>0</b>	<b>16</b>	<b>JUL 15 1988</b>		
<b>SAND &amp; GRAVEL</b>	<b>14</b>	<b>48</b>	<b>Department of Natural Resources Bureau of Land &amp; Water Resources</b>		
<b>CLAY BLUE</b>	<b>48</b>	<b>294</b>			
<b>SAND FINE GRAVEL</b>	<b>294</b>	<b>330</b>			

IF MORE SPACE IS NEEDED, USE BACK

If well telescopes please  
sketch and show depths.

GROUND LEVEL

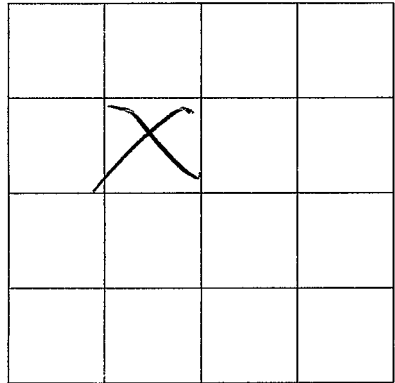

SECTION \_\_\_\_\_

Please indicate well location X.

ADDITIONAL INFORMATION

If more than one screen,  
show location of each on sketch.