

MISSISSIPPI DEPARTMENT OF NATURAL RESOURCES

Bureau of Land and Water Resources

P.O. Box 10631

Jackson, Mississippi 39209

WATER WELL DRILLERS LOG

COUNTY WELL LOCATED
Pearl River

WELL NUMBER
T 2047

CODED

DATE WELL COMPLETED
9-22-68

PERMIT NUMBER
0428

NAME OF DRILLING FIRM
Walker Well Drilling

NAME & MAILING ADDRESS OF LANDOWNER
**Steve Gurlar
Walki Bluff**

WELL LOCATION: SEC **30** TOWNSHIP **54** RANGE **18** **N** **W**

DISTANCE **10** Miles DIRECTION **N** of NEAREST TOWN **# 10**

OTHER LANDMARK
Walki Bluff

WELL PURPOSE: Home Irrigation, Municipal, Industrial, Fish Pond, etc.

PUMP DATA

PUMP TYPE (Circle One):
Submersible, Turbine, Jet, Flowing Well, Other (Describe) _____

POWER TYPE (Circle One):
Electric, Tractor, Diesel, Gasoline, Butane, Other (Describe) _____

Pump Capacity (GPM) _____ No. of Stages _____ Setting Depth _____ FT.

PUMP TEST

Well yielded _____ GPM with a drawdown of _____ ft. after _____ hours of pumping

WELL DATA

Well Depth 200	Casing Diameter (In.) 2 inch	Casing Length (Ft.) 190
Type of Casing PVC	Hole Depth 200	Depth to Static Water Level 1 foot

TYPE OF COMPLETION: (Circle One or More):
 Gravel Packed, Underreamed, Telescoped, Open Hole, Other (Describe) **an**

Top of Lap Pipe or Reduction in Casing _____ FEET IF TELESCOPED OR MORE THAN ONE SCREEN: USE BACK PAGE

LOG DATA

TYPE OF LOG RUN (Circle One):
No Log Run, Electric, Gamma Ray, Density, Sonic, Neutron, Other (Describe) _____

Name of Organization Running Log _____


SCREEN DATA

Diameter - Inches 2 inch	Length - Feet 190	Slot Size - Inches 10'
Screen Type PVC	Depth to Bottom - Feet 200 ft.	

GEOLOGIC DATA (Office Use Only)

Surface Elev.	Geologic Unit	Unit Thickness	Depth to Top
Subs. SWL	Date	Analysis	Aquifer Test


Driller's Remarks

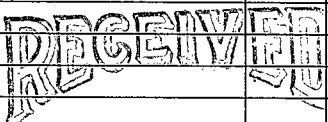DESCRIPTION OF FORMATIONS ENCOUNTERED	FROM	TO	FORMATIONS (Continued)	FROM	TO
CLAY	0	10	 NOV 22 1968 Department of Natural Resources Bureau of Land & Water Resources		
SAND	10	54			
CLAY	54	120			
SAND	120	130			
CLAY	130	150			
SAND	150	200			

IF MORE SPACE IS NEEDED, USE BACK

If well telescopes please
sketch and show depths.

GROUND LEVEL

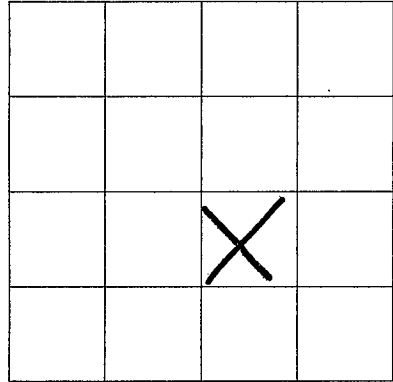

SECTION _____

Please indicate well location X.

ADDITIONAL INFORMATION

If more than one screen,
show location of each on sketch.