

MISSISSIPPI DEPARTMENT OF NATURAL RESOURCES

Bureau of Land and Water Resources

Southport Mall

P.O. Box 10631

Jackson, Mississippi 39209

WATER WELL DRILLERS LOG

P. R. WEL  
T 2048

4/20 1989 Bud Perton Jordan River  
date well completed firm name county well located

LANDOWNER:	description of formations encountered	from	to
<u>Glen Taylor</u>	<u>Red shale</u>	<u>0</u>	<u>10</u>
<u>R.T. 3 Box 280</u>	<u>White sand</u>	<u>18</u>	<u>142</u>
<u>Picayune Miss.</u>	<u>Blue shale</u>	<u>142</u>	<u>206</u>
(mailing address)	<u>Blue sand</u>	<u>206</u>	<u>402</u>


WELL LOCATION:  
sec. 11 T. 5 N R. 18 E  
S W  
8 miles North Picayune  
(distance) (direction) (nearest town)

WELL PURPOSE: None  
(home, irrigation, municipal, industrial)

WELL COMPLETION DATA:

- (1) diameter (inches) 2
- (2) total depth (feet) 402
- (3) static water level (feet) 12 below top of ground.
- (4) casing PVC, 402  
(material) (depth)  
(size) If telescope see back.
- (5) screen 10, 392  
(length) (depth to top)  
12, PVC  
(size) (material)
- (6) pump 30  
(HP) (yield gpm)  
(type power)
- (7) electric log no  
(yes or no)  
(organization running log)
- (8) how well bottom plugged Sand  
shark


DRILLERS REMARKS:  
no pump furnished

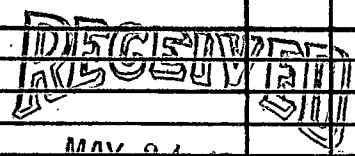

Department of Natural Resources  
Bureau of Land & Water Resources

If well telescopes please  
sketch and show depths.

GROUND LEVEL

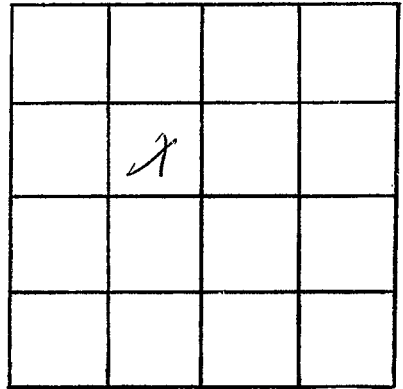

SECTION \_\_\_\_\_

Please indicate well location X.

ADDITIONAL INFORMATION

If more than one screen,  
show locations of each on sketch.