

MISSISSIPPI DEPARTMENT OF NATURAL RESOURCES

Bureau of Land and Water Resources

Southport Mall

P.O. Box 10631

Jackson, Mississippi 39209

WATER WELL DRILLERS LOG

P. RIVER
T 2051

8/15 1989 date well completed 89 Bud Penton Inc Pearl River firm name Pearl River county well located

LANDOWNER	description of formations encountered	from	to
<u>Wallace Brany</u>	<u>white shale</u>	<u>0</u>	<u>10</u>
<u>B-T-2 Box 175</u>	<u>sand &amp; gravel</u>	<u>10</u>	<u>70</u>
<u>McLagan Miss.</u>	<u>blue shale</u>	<u>70</u>	<u>240</u>
(mailing address)	<u>gray sand</u>	<u>240</u>	<u>290</u>

WELL LOCATION:  
 sec 35 T 5 N R 18 E  
 S W  
4 miles West Prigone  
 (distance) (direction) (nearest town)

WELL PURPOSE: none  
 (home, irrigation, municipal, industrial)


WELL COMPLETION DATA:

- (1) diameter (inches) 2"
- (2) total depth (feet) 290
- (3) static water level (feet) 8 below above top of ground.
- (4) casing PVC 290  
 (material) (depth)
- (size) if telescope see back.
- (5) screen 5' 285  
 (length) (depth to top)
- (size) (material)
- (6) pump 1/2 450  
 (HP) (yield gpm)
- (type power)
- (7) electric log no  
 (yes or no)

(organization running log)

(8) how well bottom plugged good

DRILLERS REMARKS:

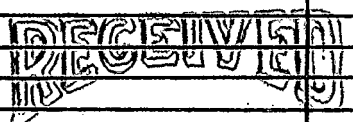

Department of Natural Resources  
 Bureau of Land & Water Resources

