

MISSISSIPPI DEPARTMENT OF NATURAL RESOURCES

Bureau of Land and Water Resources

P.O. Box 10631

Jackson, Mississippi 39209

WATER WELL DRILLERS LOG

COUNTY WELL LOCATED <i>Pearl River</i>	
WELL NUMBER <i>51T</i>	CODED
DATE WELL COMPLETED <i>3-27-90</i>	

PERMIT NUMBER <i>0-519</i>
NAME OF DRILLING FIRM <i>Walters Well Service</i>

NAME & MAILING ADDRESS OF LANDOWNER <i>Tommy Seal's Pt. 1 Industrial</i>		
WELL LOCATION: SEC <i>27</i> TOWNSHIP <i>5 N</i> RANGE <i>18 E</i>		
DISTANCE <i>10</i> Miles	DIRECTION <i>North</i>	NEAREST TOWN <i>Raylene</i>
OTHER LANDMARK <i>VAMACRAW</i>		
WELL PURPOSE <input checked="" type="checkbox"/> Home, <input type="checkbox"/> Irrigation, <input type="checkbox"/> Municipal, <input type="checkbox"/> Industrial, <input type="checkbox"/> Fish Pond, etc.		

PUMP DATA		
PUMP TYPE (Circle One): Submersible, Turbine, <input checked="" type="radio"/> Jet, Flowing Well, Other (Describe) _____		
POWER TYPE (Circle One): <input checked="" type="radio"/> Electric, <input type="radio"/> Tractor, <input type="radio"/> Diesel, <input type="radio"/> Gasoline, <input type="radio"/> Butane, Other (Describe) _____ H/P _____		
Pump Capacity (GPM) <i>10</i>	No. of Stages <i>1</i>	Setting Depth <i>25</i> FT.
PUMP TEST		
Well yielded _____ GPM with a drawdown of _____ ft. after _____ hours of pumping		

WELL DATA		
Well Depth <i>126</i>	Casing Diameter (In.) <i>2</i>	Casing Length (Ft.) <i>116</i>
Type of Casing <i>PVC</i>	Hole Depth <i>126</i>	Depth to Static Water Level <i>0</i>
TYPE OF COMPLETION: (Circle One or More): <input checked="" type="checkbox"/> Gravel Packed, <input type="checkbox"/> Underreamed, <input type="checkbox"/> Telescoped, <input checked="" type="checkbox"/> Natural Development, <input type="checkbox"/> Open Hole, <input type="checkbox"/> Other (Describe) _____		
Top of Lap Pipe or Reduction in Casing FEET <input type="checkbox"/> IF TELESCOPED OR MORE THAN ONE SCREEN: USE BACK PAGE		

LOG DATA	
TYPE OF LOG RUN (Circle One): No Log Run, Electric, Gamma Ray, Density, Sonic, Neutron, Other (Describe) _____	
Name of Organization Running Log	

SCREEN DATA		
Diameter - Inches <i>2</i>	Length - Feet <i>10</i>	Slot Size - Inches <i>#12</i>
Screen Type <i>Slot</i>		Depth to Bottom - Feet <i>126</i>

GEOLOGIC DATA (Office Use Only)			
Surface Elev.	Geologic Unit	Unit Thickness	Depth to Top
Subs. SWL	Date	Analysis	Aquifer Test
Driller's Remarks			


DESCRIPTION OF FORMATIONS ENCOUNTERED	FROM	TO	FORMATIONS (continued)
<i>sand</i>	<i>0</i>	<i>10</i>	<div style="border: 2px solid black; padding: 5px; display: inline-block; transform: rotate(-15deg);"> DRILLER'S LOG MAY 25 1990 </div>
<i>rocks</i>	<i>10</i>	<i>80</i>	
<i>blue clay</i>	<i>80</i>	<i>100</i>	
<i>sand</i>	<i>100</i>	<i>126</i>	

Department of Natural Resources
 Bureau of Land & Water Resources

IF MORE SPACE IS NEEDED, USE BACK

If well telescopes please
sketch and show depths.

GROUND LEVEL

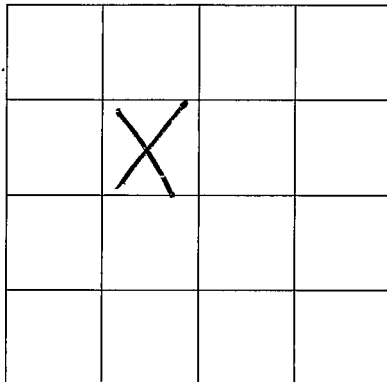

SECTION _____

Please indicate well location X.

ADDITIONAL INFORMATION

If more than one screen,
show location of each on sketch.