

MISSISSIPPI DEPARTMENT OF NATURAL RESOURCES

Bureau of Land and Water Resources

Southport Mall

P.O. Box 10631

Jackson, Mississippi 39209

WATER WELL DRILLERS LOG

P. River
T 2050

8/10 1990
date well completed

Bud Penton
firm name

Pearl River
county well located

LANDOWNER: Raymond Lewis
R.T. 2 Box 202
Picayune Miss.
(mailing address)

WELL LOCATION:
sec 28 T 5 N R 18 E
S W
7 miles W of Picayune
(distance) (direction) (nearest town)

WELL PURPOSE: Mem
(home, irrigation, municipal, industrial)

- WELL COMPLETION DATA:
- (1) diameter (inches) 2"
 - (2) total depth (feet) 1574
 - (3) static water level (feet) 18 1/2 below top of ground.
 - (4) casing PVC 1574
(material) (depth)
 - (size) if telescope see back.
 - (5) screen 20 1554
(length) (depth to top)
 - 12 PVC
(size) (material)
 - (6) pump 700 700
(HP) (yield gpm)
 - 700
(type power)
 - (7) electric log NO
(yes or no)
 - (organization running log)
 - (8) how well bottom plugged and
shut

description of formations encountered	from	to
white shale	0	9
white sand	9	42
Blue Shale	42	55
gray sand	55	105
Blue Shale	105	290
gray sand	290	348
Blue Shale	348	360
gray sand	360	450
Blue Shale	450	635
gray sand	635	685
Blue Shale	685	795
gray sand	795	900
Blue Shale	900	1450
gray sand	1450	1574


RECEIVED
OCT 15 1990

Department of Natural Resources
Bureau of Land & Water Resources

DRILLERS REMARKS:

If well telescopes please sketch and show depths.

GROUND LEVEL

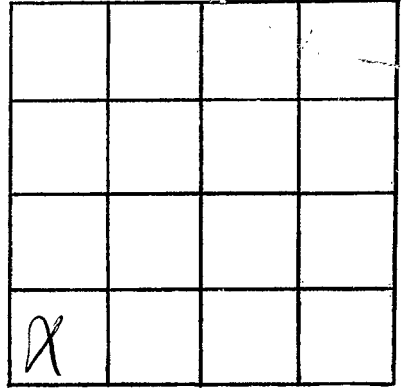

SECTION _____

Please indicate well location X.

ADDITIONAL INFORMATION

If more than one screen,
show locations of each on sketch.