

MISSISSIPPI DEPARTMENT OF ENVIRONMENTAL QUALITY
Bureau of Land and Water Resources

P. O. Box 10631
Jackson, MS 39289-0631
WATER WELL DRILLERS LOG

COUNTY WELL LOCATED
Paul Kiner

WELL NUMBER **T** CODED

2062
DATE WELL COMPLETED
12-20-91

PERMIT NUMBER
0-519

NAME OF DRILLING FIRM
Walters Well Service

NAME & MAILING ADDRESS OF LANDOWNER
Ralph Ferguson
RTI CARRIER MS

WELL LOCATION: SEC **24** TOWNSHIP **5 N** RANGE **18 E**

DISTANCE **7** Miles **NORTH** of **PICAYUNE**

OTHER LANDMARK

WELL PURPOSE Home Irrigation, Municipal, Industrial, Fish Pond, etc.

PUMP DATA

PUMP TYPE (Circle One):
Submersible, Turbine, Jet, Flowing Well,
Other (Describe) _____

POWER TYPE (Circle One):
 Electric, Tractor, Diesel, Gasoline, Butane,
Other (Describe) _____ H/P _____

Pump Capacity (GPM) **7** No. of Stages **1** Setting Depth **25** FT.

PUMP TEST

Well yielded _____ GPM with
a drawdown of _____ ft.
after _____ hours of pumping

WELL DATA

Well Depth **280** Casing Diameter (In.) **2** Casing Length (Ft.) **270**

Type of Casing **PVC** Hole Depth **280** Depth to Static Water Level **10'**

TYPE OF COMPLETION: (Circle One or More):
Gravel Packed, Underreamed, Telescoped,
Natural Development, Open Hole, Other
(Describe) _____

Top of Lap Pipe or Reduction in Casing

FEET IF TELESCOPED OR MORE THAN ONE SCREEN: USE BACK PAGE

LOG DATA

TYPE OF LOG RUN (Circle One):
No Log Run, Electric, Gamma Ray, Density, Sonic, Neutron,
Other (Describe) _____

Name of Organization Running Log

SCREEN DATA

Diameter - Inches **2** Length - Feet **10** Slot Size - Inches **12**

Screen Type **Slot** Depth to Bottom - Feet **280**

GEOLOGIC DATA (Office Use Only)

Surface Elev.	Geologic Unit	Unit Thickness	Depth to Top
Subs. SWL	Date	Analysis	Aquifer Test


Driller's Remarks

DESCRIPTION OF FORMATIONS ENCOUNTERED	FROM	TO	FORMATIONS (Continued)	FROM	TO
Black dirt	0	10	RECEIVED APR 17 1992 Dept. of Environmental Quality Bureau of Land & Water Resources		
white clay	10	25			
Sand & Rock	25	80			
Blue Clay	80	160			
White Clay	160	180			
Blue Clay	180	230			
Sand	230	280			

IF MORE SPACE IS NEEDED, USE BACK

If well telescopes please
sketch and show depths.

GROUND LEVEL

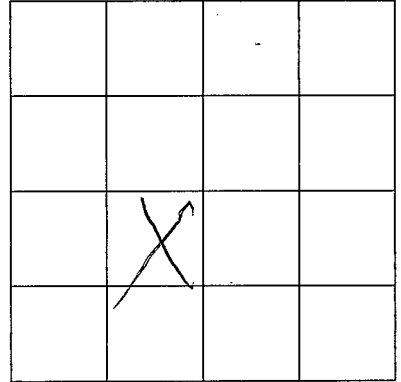

SECTION _____

Please indicate well location X.

ADDITIONAL INFORMATION

If more than one screen,
show location of each on sketch.