

MISSISSIPPI DEPARTMENT OF NATURAL RESOURCES

Bureau of Land and Water Resources

Southport Mall

P.O. Box 10631

Jackson, Mississippi 39209

WATER WELL DRILLERS LOG

P. RIVER  
T 2064

5/13 1981 Bud Penton Pearl River  
date well completed firm name county well located


LANDOWNER: Steven Medlock  
R. T. Bay  
Carriere Miss.  
(mailing address)

description of formations encountered	from	to
	white clay	0
white sand	10	90
Blue shale	70	240
gray sand	240	266

WELL LOCATION:  
sec. 23 T. 5 N R. 18 E  
6 miles East of Carriere  
(distance) (direction) (nearest town)

WELL PURPOSE: none  
(home, irrigation, municipal, industrial)

- WELL COMPLETION DATA:
- (1) diameter (inches) 2
  - (2) total depth (feet) 266
  - (3) static water level (feet) 10 below top of ground.
  - (4) casing pvc, 266 (material) (depth)
  - (size) if telescope see back.
  - (5) screen 10, 256 (length) (depth to top)
  - 12, pvc (size) (material)
  - (6) pump 1/2, 3.50 (HP) (yield gpm)
  - (type power) ~~electric~~ no
  - (7) electric log ~~yes~~ no (yes or no)
  - (organization running log)
  - (8) how well bottom plugged sand

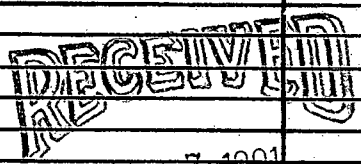


JUN 7 1991

Dept. of Environmental Quality  
Bureau of Land & Water Resources

DRILLERS REMARKS: Shook

If well telescopes please sketch and show depths.

GROUND LEVEL

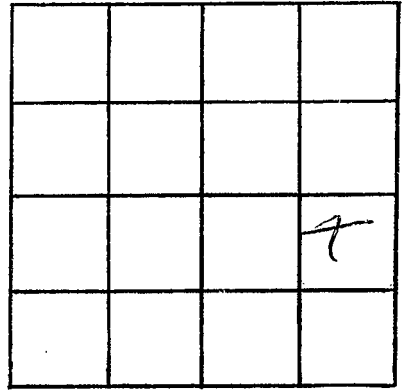

SECTION \_\_\_\_\_

Please indicate well location X.

ADDITIONAL INFORMATION

If more than one screen,  
show locations of each on sketch.