

**MISSISSIPPI DEPARTMENT OF ENVIRONMENTAL QUALITY**  
Bureau of Land and Water Resources

P. O. Box 10631  
Jackson, MS 39289-0631  
**WATER WELL DRILLERS LOG**

COUNTY WELL LOCATED <b>T. RIVER</b>	
WELL NUMBER <b>T</b>	CODED
<b>2006</b>	
DATE WELL COMPLETED	

PERMIT NUMBER <b>0-519</b>
NAME OF DRILLING FIRM <b>Walkers Well Service</b>

NAME & MAILING ADDRESS OF LANDOWNER <b>Tony Rozzario</b>			
WELL LOCATION:	SEC	TOWNSHIP	RANGE
	<b>36</b>	<b>S</b>	<b>18</b>
			<b>N</b>
			<b>W</b>
DISTANCE	DIRECTION	NEAREST TOWN	
<b>14</b> Miles	<b>North</b>	<b>Prairie</b>	
OTHER LANDMARK <b>Cypress Hills</b>			
WELL PURPOSE: Home, Irrigation, Municipal, Industrial, Fish Pond, etc.			

PUMP DATA			
PUMP TYPE (Circle One): <u>Submersible</u> Turbine, Jet, Flowing Well, Other (Describe) _____			
POWER TYPE (Circle One): <u>Electric</u> Tractor, Diesel, Gasoline, Butane, Other (Describe) _____ H/P <b>3</b>			
Pump Capacity (GPM)	No. of Stages	Setting Depth	
<b>10</b>	<b>12</b>	<b>160</b> FT.	
PUMP TEST			
Well yielded _____ GPM with a drawdown of _____ ft. after _____ hours of pumping			

WELL DATA		
Well Depth <b>380</b>	Casing Diameter (In.) <b>4</b>	Casing Length (Ft.) <b>380</b>
Type of Casing <b>PVC</b>	Hole Depth <b>382</b>	Depth to Static Water Level <b>120'</b>
TYPE OF COMPLETION: (Circle One or More): <u>Gravel Packed</u> , Underreamed, Telescoped, Natural Development, Open Hole, Other (Describe) _____		
Top of Lap Pipe or Reduction in Casing		
FEET	IF TELESCOPED OR MORE THAN ONE SCREEN: USE BACK PAGE	

LOG DATA	
TYPE OF LOG RUN (Circle One): No Log Run, Electric, Gamma Ray, Density, Sonic, Neutron, Other (Describe) _____	
Name of Organization Running Log	

SCREEN DATA		
Diameter - Inches <b>4</b>	Length - Feet <b>20'</b>	Slot Size - Inches <b>12</b>
Screen Type <b>Slot</b>	Depth to Bottom - Feet <b>380</b>	


GEOLOGIC DATA (Office Use Only)			
Surface Elev.	Geologic Unit	Unit Thickness	Depth to Top
Subs. SWL	Date	Analysis	Aquifer Test
Driller's Remarks			

DESCRIPTION OF FORMATIONS ENCOUNTERED	FROM	TO	FORMATIONS (Continued)	FROM	TO
<b>Back dirt</b>	<b>0</b>	<b>10</b>	<b>RECEIVED</b> <b>APR 17 1992</b> <b>Dept. of Environmental Quality</b> <b>Bureau of Land &amp; Water Resources</b>		
<b>Grey clay</b>	<b>10</b>	<b>20</b>			
<b>White sand</b>	<b>20</b>	<b>30</b>			
<b>Blue clay</b>	<b>30</b>	<b>40</b>			
<b>Sand &amp; Rocks</b>	<b>40</b>	<b>80</b>			
<b>Blue clay</b>	<b>80</b>	<b>110</b>			
<b>Sand</b>	<b>110</b>	<b>180</b>			
<b>Blue clay</b>	<b>180</b>	<b>200</b>			
<b>sand</b>	<b>200</b>	<b>380</b>			

IF MORE SPACE IS NEEDED, USE BACK

If well telescopes please  
sketch and show depths.

GROUND LEVEL

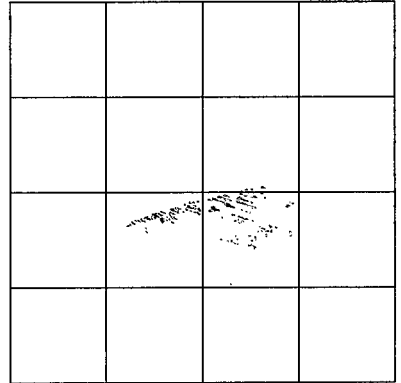

SECTION \_\_\_\_\_

Please indicate well location X.

ADDITIONAL INFORMATION

If more than one screen,  
show location of each on sketch.