

MISSISSIPPI DEPARTMENT OF NATURAL RESOURCES

Bureau of Land and Water Resources

Southport Mall

P.O. Box 10631

Jackson, Mississippi 39209

WATER WELL DRILLERS LOG

Handwritten: Pearl River, T 2007

5/18 date well completed, 1992 Bed Penton firm name, Pearl River county well located

LANDOWNER: Darrk Perry, Charles Walker Rd (mailing address)

description of formations encountered	from	to
white shale	0	13
white sand	13	80
Blue shale	80	145
Gray sand	145	183

WELL LOCATION: sec 35 T 5 N R 18 E, 9 miles W Pearl (distance, direction, nearest town)

WELL PURPOSE: none (home, irrigation, municipal, industrial)

- WELL COMPLETION DATA:
- (1) diameter (inches) 2"
  - (2) total depth (feet) 183
  - (3) static water level (feet) 7 below top of ground.
  - (4) casing PVC, 183 (material, depth)
  - (5) screen 5' 179 (length, depth to top)
  - (6) pump 1/2 8 (HP, yield gpm)
  - (7) electric log NO (type power, yes or no)
  - (8) how well bottom plugged Sand


RECEIVED JUN 08 1992

Dept of Environmental Quality Bureau of Land & Water Resources

DRILLERS REMARKS:

If well telescopes please sketch and show depths.

GROUND LEVEL

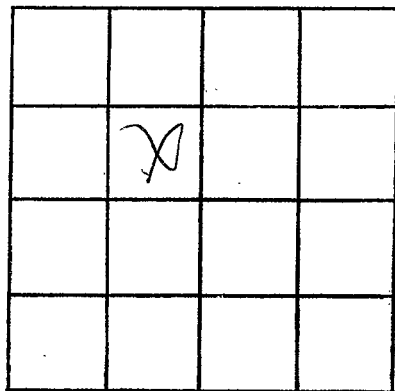

SECTION \_\_\_\_\_

Please indicate well location X.

ADDITIONAL INFORMATION

If more than one screen,  
show locations of each on sketch.