

MISSISSIPPI DEPARTMENT OF NATURAL RESOURCES

Bureau of Land and Water Resources

Southport Mall

P.O. Box 10631

Jackson, Mississippi 39209

WATER WELL DRILLERS LOG

P. River  
T 2069

7-23-92 Bud Penton Water Well Pearl River  
date well completed firm name county well located

LANDOWNER: Ronnie Brown  
Rt 2 Box 378 Carriere  
Ms 39426 Pine Grove Rd  
(mailing address)

description of formations encountered	from	to
White shale	0	10
White sand	10	28
Blue shale	28	203
White sand	203	380


WELL LOCATION:

sec. 14 T 5 N R 18 E  
S W  
1/2 miles SW of Cybur  
(distance) (direction) (nearest town)

WELL PURPOSE: Home  
(home, irrigation, municipal, industrial)

WELL COMPLETION DATA:

- (1) diameter (inches) 5
- (2) total depth (feet) 380
- (3) static water level (feet) 12 <sup>below</sup> above top of ground.
- (4) casing PVC 370  
(material) (depth)  
2" if telescope see back.  
(size)
- (5) screen 10' 370'  
(length) (depth to top)  
2" PVC  
(size) (material)
- (6) pump none  
(HP) (yield gpm)  
(type power)
- (7) electric log NO  
(yes or no)  
(organization running log)
- (8) how well bottom plugged sandshark

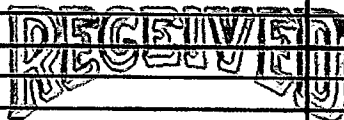

AUG 19 1992

Dept. of Environmental Quality  
Bureau of Land & Water Resources

DRILLERS REMARKS:

If well telescopes please sketch and show depths.

GROUND LEVEL

		X	

SECTION 14

Please indicate well location X.

ADDITIONAL INFORMATION

If more than one screen,  
show locations of each on sketch.