

MISSISSIPPI DEPARTMENT OF NATURAL RESOURCES

Bureau of Land and Water Resources

Southport Mall

P.O. Box 10631

Jackson, Mississippi 39209

WATER WELL DRILLERS LOG

P. RIVER
 T
 2000

7-6 1992 Bud Penton Water Well Pearl River
 date well completed firm name county well located

LANDOWNER: Joe Diecidue
 R.T. 2 Box 1373
 Pine Grove Rd
 (mailing address)

description of fomations encountered	from	to
white shale	0	10
White Sand	10	61
White Shale	61	85
White Sand	85	115
Blue Shale	115	162
White Sand	162	185
Blue Shale	185	200
GRAY SAND	200	386
Blue Shale	386	615
GRAY SAND	615	703
Blue Shale	703	770
GRAY SAND	770	820

WELL LOCATION:
 sec. 14 T. 5 N R. 18 E
 S W
 1/2 miles SW of Cyber
 (distance) (direction) (nearest town)

WELL PURPOSE: Home
 (home, irrigation, municipal, industrial)

WELL COMPLETION DATA:

- (1) diameter (inches) 5
- (2) total depth (feet) 820
- (3) static water level (feet) 5' below top of ground.
- (4) casing PVC 805' (material) (depth)
 2" (size) if telescope see back.
- (5) screen 15' 805' (length) (depth to top)
 2" (size) PVC (material)
- (6) pump None (HP) (yield gpm)
 (type power)
- (7) electric log NO (yes or no)
 (organization running log)
- (8) how well bottom plugged sandshark




AUG 19 1992

DRILLERS REMARKS:

Dept. of Environmental Quality
 Bureau of Land & Water Resources

If well telescopes please sketch and show depths.

GROUND LEVEL

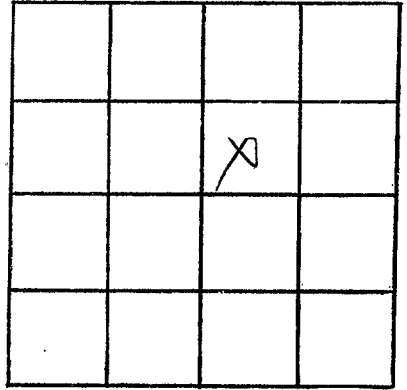

SECTION 14

Please indicate well location X.

ADDITIONAL INFORMATION

If more than one screen,
show locations of each on sketch.