

MISSISSIPPI DEPARTMENT OF NATURAL RESOURCES

Bureau of Land and Water Resources

Southport Mall

P.O. Box 10631

Jackson, Mississippi 39209

WATER WELL DRILLERS LOG

River  
T 2072

11-23 1992 Bud Penton Water Well Pearl River  
date well completed firm name county well located

LANDOWNER: Paul Pellegrine  
103 Seeger Ln Carriere  
MS 39426  
(mailing address)

WELL LOCATION:  
sec. 35 T 5 N R 18 E  
5 miles North of Picayune  
(distance) (direction) (nearest town)

WELL PURPOSE: Home  
(home, irrigation, municipal, industrial)

- WELL COMPLETION DATA:
- (1) diameter (inches) 4
  - (2) total depth (feet) 670
  - (3) static water level (feet) 60 below above top of ground.
  - (4) casing PVC 660'  
(material) (depth)  
4x2" if telescope see back.  
(size)
  - (5) screen 10 660'  
(length) (depth to top)  
2 PVC  
(size) (material)
  - (6) pump 1 18  
(HP) (yield gpm)  
elec  
(type power)
  - (7) electric log NO  
(yes or no)
- (organization running log)
- (8) how well bottom plugged Sandshank

| description of formations encountered | from | to  |
|---------------------------------------|------|-----|
| white clay                            | 0    | 18  |
| red sand                              | 18   | 127 |
| blue clay                             | 127  | 220 |
| gray sand                             | 220  | 420 |
| blue clay                             | 420  | 480 |
| gray sand                             | 480  | 530 |
| blue clay                             | 530  | 609 |
| gray sand                             | 609  | 670 |

REGISTERED  
FEB 25 1993


Dept. of Environmental Quality  
Office of Land & Water Resources

DRILLERS REMARKS:

If well telescopes please sketch and show depths.

GROUND LEVEL

158' 4"  
5 1/2' 2"

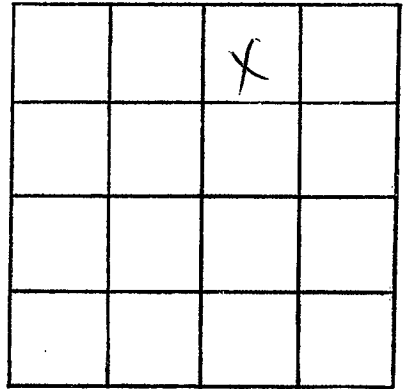

SECTION \_\_\_\_\_

Please indicate well location X.

ADDITIONAL INFORMATION

If more than one screen,  
show locations of each on sketch.