

PEARL RIVER
T
2078

**MISSISSIPPI  
BOARD OF WATER COMMISSIONERS**  
416 North State Street  
Jackson, Mississippi 39201

**WATER WELL DRILLERS LOG**

5-23 1978 Bud Benton & Son Pearl River  
 date well completed firm name county well located

**LANDOWNER:**  
Ethelene Cole  
Decatur, Mo.  
 (mailing address)

description of formations encountered	from	to
<u>White Shale</u>	<u>0</u>	<u>18</u>
<u>sand</u>	<u>18</u>	<u>65</u>

**WELL LOCATION:**  
 sec 14 T 5 N R 18 E  
10 miles W of Decatur  
 (distance) (direction) (nearest town)

**WELL PURPOSE:** Home  
 (home, irrigation, municipal, industrial)

**WELL COMPLETION DATA:**

(1) diameter (inches) 2 in

(2) total depth (feet) 65

(3) static water level (feet) 8 below above top of ground.

(4) casing PVC 65  
 (material) (depth)

         if telescope see back.  
 (size)

(5) screen 2x5 60  
 (length) (depth to top)

12 PVC  
 (size) (material)

(6) pump 1/2 350  
 (HP) (yield gpm)

electric  
 (type power)

(7) electric log No  
 (yes or no)

(organization running log)


(8) how well bottom plugged Sand Shale

**DRILLERS REMARKS:**

**RECEIVED**  
 JUL 31 1978  
 MISS. BD. OF WATER COMMISSIONERS

If well telescopes please sketch and show depths.

GROUND LEVEL

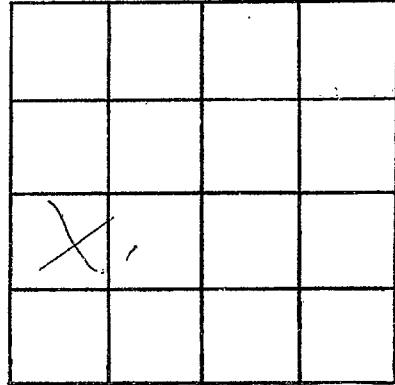

SECTION \_\_\_\_\_

Please indicate well location X.

ADDITIONAL INFORMATION

If more than one screen,  
show locations of each on sketch.