

MISSISSIPPI DEPARTMENT OF NATURAL RESOURCES

Bureau of Land and Water Resources

COUNTY WELL LOCATED	
FRANKLIN	
WELL NUMBER	CODED
72036	2081
DATE WELL COMPLETED	
2-6-87	

PERMIT NUMBER
0-428
NAME OF DRILLING FIRM
WALKER'S WELL DRILLING
T REPAIR SHOP

P.O. Box 10631
Jackson, Mississippi 39209
WATER WELL DRILLERS LOG

NAME & MAILING ADDRESS OF LANDOWNER		
JOE STOUT		
ENDUSTIAL		
WELL LOCATION: SEC TOWNSHIP RANGE		
23	5	N 18 E
DISTANCE DIRECTION NEAREST TOWN		
17 Miles	NW of	PICAYUNE
OTHER LANDMARK		
WELL PURPOSE: <input checked="" type="radio"/> Home, Irrigation, Municipal, Industrial, Fish Pond, etc.		

PUMP DATA		
PUMP TYPE (Circle One): Submersible, Turbine, <input checked="" type="radio"/> Jet Flowing Well, Other (Describe) _____		
POWER TYPE (Circle One): <input checked="" type="radio"/> Electric Tractor, Diesel, Gasoline, Butane, Other (Describe) _____		
Pump Capacity (GPM)	No. of Stages	Setting Depth
8	1	20 FT.
PUMP TEST		
Well yielded _____ GPM with a drawdown of _____ ft. after _____ hours of pumping		

WELL DATA		
Well Depth	Casing Diameter (In.)	Casing Length (Ft.)
50'	2"	40'
Type of Casing	Hole Depth	Depth to Static Water Level
PVC	52'	7'
TYPE OF COMPLETION: (Circle One or More): Gravel Packed, Underreamed, Telescoped, Natural Development, Open Hole, Other		
(Describe) AIR		
Top of Lap Pipe or Reduction in Casing		
FEET IF TELESCOPED OR MORE THAN ONE SCREEN: USE BACK PAGE		

LOG DATA	
TYPE OF LOG RUN (Circle One): No Log Run, Electric, Gamma Ray, Density, Sonic, Neutron, Other (Describe) _____	
Name of Organization Running Log	

SCREEN DATA		
Diameter - Inches	Length - Feet	Slot Size - Inches
2"	10'	#10
Screen Type	Depth to Bottom - Feet	
SLOT	50'	

GEOLOGIC DATA (Office Use Only)			
Surface Elev.	Geologic Unit	Unit Thickness	Depth to Top
Subs. SWL	Date	Analysis	Aquifer Test

Driller's Remarks


RECEIVED

DESCRIPTION OF FORMATIONS ENCOUNTERED	FROM	TO	FORMATION (continued)	FROM	TO
CLAY	0	10	<div style="font-size: 1.5em; font-weight: bold; margin-bottom: 10px;">MAY 14 1987</div> <div style="text-align: center;"> Department of Natural Resources Bureau of Land & Water Resources </div>		
SAND	10	15			
PEGRAVEL	15	25			
Big GRAVEL	25	52'			

IF MORE SPACE IS NEEDED, USE BACK

If well telescopes please sketch and show depths.

GROUND LEVEL

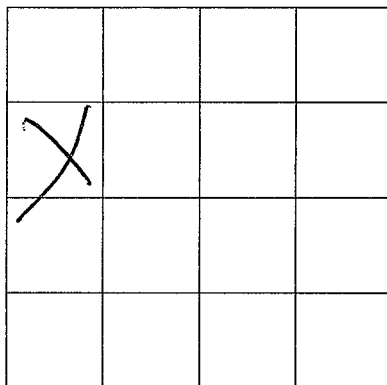

SECTION _____

Please indicate well location X.

ADDITIONAL INFORMATION

If more than one screen,
show location of each on sketch.