

13V

CODED

Pearl River
WZ
12-2-68

MISSISSIPPI
BOARD OF WATER COMMISSIONERS
416 North State Street
Jackson, Mississippi 39201

WATER WELL DRILLERS LOG

12-2 1968 Ponton Well Serv Pearl River
date well completed firm name county well located

LANDOWNER: W.B. Welborn
P.O. 2 Box 226-14
Picayune MISS
(mailing address)
WELL LOCATION:
sec. 20 T. 5 S. R. 17 W.
3 miles N.W. of Picayune
(distance) (direction) (nearest town)

description of formations encountered	from	to
Red Clay	0	16
" Sand	16	20
White Clay	20	38
Blue Clay	38	98
Brown Sand	98	110
Brown Clay	110	116
Blue Clay	116	260
Grey Sand	260	300

WELL PURPOSE: HOE FARM
(home, irrigation, municipal, industrial)

WELL COMPLETION DATA: 4 1/2 Drilled

- (1) diameter (inches) 2"
- (2) total depth (feet) 300
- (3) static water level (feet) 62 below top of ground.
- (4) casing Galv, 295
(material) (depth)
2"
(size) if telescope see back.
- (5) screen 5', 295
(length) (depth to top)
2", S. steel
(size) (material)
- (6) pump 1, 11
(HP) (yield gpm)
Elec
(type power)
- (7) electric log NO
(yes or no)
(organization running log)
- (8) how well bottom plugged Bur Valve

CODED


DEC 20 1968

DRILLERS REMARKS:

MISS. BD. OF
WATER COM. 7.

If well telescopes please sketch and show depths.

GROUND LEVEL

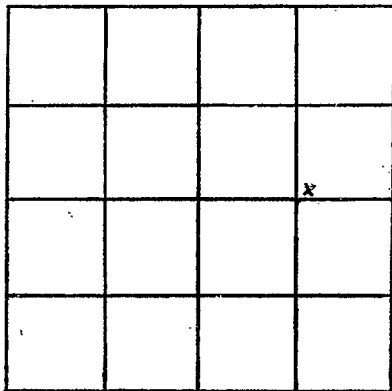

SECTION 20

Please indicate well location X.

ADDITIONAL INFORMATION

If more than one screen,
show locations of each on sketch.