

Pearl River
 U4
 4-69

MISSISSIPPI
 BOARD OF WATER COMMISSIONERS
 416 North State Street
 Jackson, Mississippi 39201

CODED

WATER WELL DRILLERS LOG

NEW HAMPKIN WELLS DRILLING SERVICE
 P. O. BOX 117
 CARROLL, MISS.
 firm name

Pearl River
 county well located

4-29 1969
 date well completed

LANDOWNER: David
 Stockstill

description of formations encountered	from	to
	surface clay	0
" sand	20	60
white clay	60	80
" sand	80	120
hard blue clay	120	155
good sand	155	174

Carrier, Route
 (mailing address)

WELL LOCATION:
 sec. 23 T. 5 S. R. 17 E.
 3 miles South Carrier
 (distance) (direction) (nearest town)

WELL PURPOSE: home
 (home, irrigation, municipal, industrial)

WELL COMPLETION DATA:

- (1) diameter (inches) 2"
- (2) total depth (feet) 174'
- (3) static water level (feet) 65' below top of ground.
- (4) casing galv. 168' (material), (depth)
 2" (size) if telescope see back.
- (5) screen 5' (length), (depth to top)
 2" (size), St. Steel (material)
- (6) pump 1 (HP), 500 gpm (yield) gpm.
 electric (type power)
- (7) electric log no (yes or no)
- (organization running log)
- (8) how well bottom plugged Back pressure valve


DRILLERS REMARKS:

JUL 14 1969

MISS. Bd. of WATER COM. STAMP

If well telescopes please sketch and show depths.

GROUND LEVEL

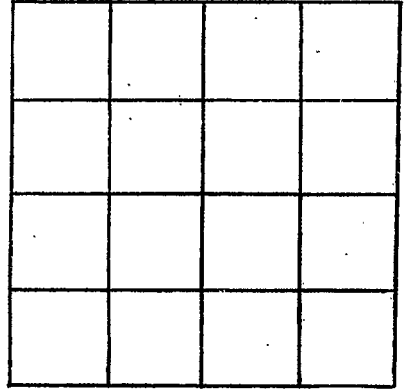

SECTION _____

Please indicate well location X.

ADDITIONAL INFORMATION

If more than one screen,
show locations of each on sketch.