

Pearl River
 U 5
 5-69

MISSISSIPPI
 BOARD OF WATER COMMISSIONERS
 416 North State Street
 Jackson, Mississippi 39201

CODED

WATER WELL DRILLERS LOG

5-22-69 date well completed
 NEIL LUMPKIN WELL DRILLING SERVICE P. O. BOX 117 CARRIERE, MISS.
 Pearl River county well located

LANDOWNER: J.E. Walker
 Carriere Route
 (mailing address)

description of formations encountered	from	to
Surface Clay	0	10
Sand & gravel	10	69

WELL LOCATION:
 sec. 7 T. 5 R. 17
 7 miles West of Carriere
 (distance) (direction) (nearest town)

WELL PURPOSE: home
 (home, irrigation, municipal, industrial)

- WELL COMPLETION DATA:
- (1) diameter (inches) 2"
 - (2) total depth (feet) 69'
 - (3) static water level (feet) 20 below above top of ground.
 - (4) casing galv. (material), (depth) 2" (size) if telescope see back.
 - (5) screen 5' (length), (depth to top) 2" St. Steel (size) (material).
 - (6) pump 1/2 500 per hr. (HP) (yield gpm) electric (type power)
 - (7) electric log No. (yes or no)

(organization running log)
 (8) how well bottom plugged rock pressure valve


DRILLERS REMARKS:

JUL 14 1969

MISS. BD. OF
 WATER COMMISSIONERS

If well telescopes please sketch and show depths.

GROUND LEVEL

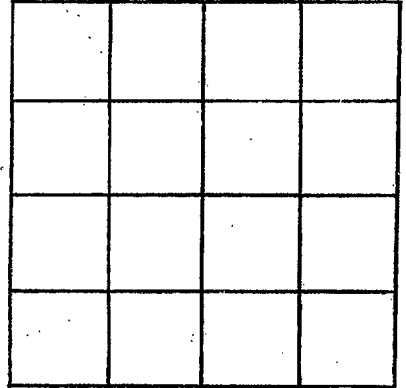

SECTION _____

Please indicate well location X.

ADDITIONAL INFORMATION

If more than one screen,
show locations of each on sketch.