

CODED

Pearl River
U 6
6-23-69

MISSISSIPPI
BOARD OF WATER COMMISSIONERS
416 North State Street
Jackson, Mississippi 39201

WATER WELL DRILLERS LOG

6-23 1969 E. J. Waterwell Serv. Pearl River
date well completed firm name county well located

LANDOWNER: Spitman Carter description of formations encountered from to
Ozona Miss. Red surface clay 0 18'
Coarse white sh. 18 60'
Gravel

WELL LOCATION:
sec. 26 T. 5 N. R. 17 E.
1 miles SW. of Ozona
(distance) (direction) (nearest town)

WELL PURPOSE: Home
(home, irrigation, municipal, industrial)

WELL COMPLETION DATA:


- (1) diameter (inches) 4 3/4
- (2) total depth (feet) 60
- (3) static water level (feet) 26' below top of ground.
- (4) casing Plastic 55'
(material) (depth)
2" if telescope see back.
(size)
- (5) screen 5' 55-60'
(length) (depth to top)
2" Plastic
(size) (material)
- (6) pump 1/2 400
(HP) (yield gpm)
Elect.
(type power)
- (7) electric log NO
(yes or no)

(organization running log)

(8) how well bottom plugged Shoe


DRILLERS REMARKS:

E. B. Lester

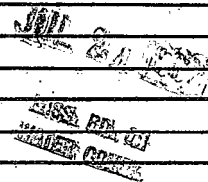

If well telescopes please sketch and show depths.

GROUND LEVEL

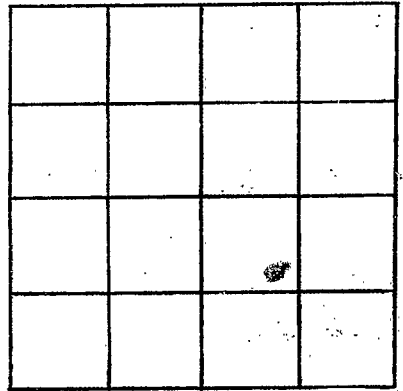

SECTION 26

Please indicate well location X.

ADDITIONAL INFORMATION

If more than one screen,
show locations of each on sketch.