

CODED

MISSISSIPPI BOARD OF WATER COMMISSIONERS  
416 North State Street  
Jackson, Mississippi 39201

WATER WELL DRILLERS LOG

Pearl River  
U7  
6-30-69

6-30 1969 date well completed  
H. J. Water Well Co. firm name  
Pearl River county well located

LANDOWNER: Robert P. Par  
Ozona, Miss.  
(mailing address)

description of formations encountered	from	to
Red clay	0	18
whit sd. in gravel	18	70
Blue clay	70	105
Red sd. / fine	105	150
Blue clay	150	162
Blue fine sd.	162	168
Blue clay	168	185
Blue sd. / part clay sh.	185	200
Blue clay	200	257
Blue coarse sh.	257	300


WELL LOCATION:  
sec 35 T 5 N R 17 E  
1 miles south of Ozona  
(distance) (direction) (nearest town)

WELL PURPOSE: Home  
(home, irrigation, municipal, industrial)

WELL COMPLETION DATA:


- (1) diameter (inches) 4.5
- (2) total depth (feet) 300
- (3) static water level (feet) 70 below above top of ground.
- (4) casing Galv. 295 (material) (depth)
- 2 if telescope see back. (size)
- (5) screen 5 295 (length) (depth to top)
- 2" 5 Steel (size) (material)
- (6) pump 1 500 (HP) (yield gpm)
- Elect. (type power)
- (7) electric log NO. (yes or no)
- (organization running log)
- (8) how well bottom plugged Shoe

DRILLERS REMARKS:  
E. B. Foster

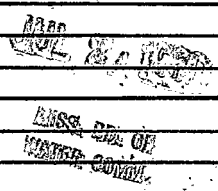

If well telescopes please sketch and show depths.

GROUND LEVEL

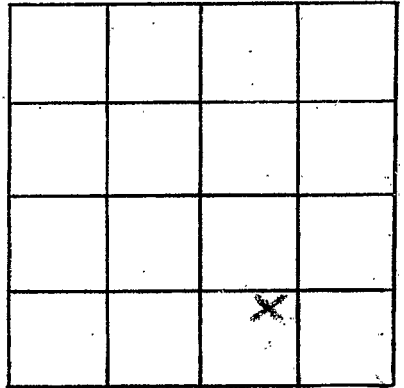

SECTION 25

Please indicate well location X.

ADDITIONAL INFORMATION

If more than one screen, show locations of each on sketch.