

CODED

Pearl River  
U8  
7-17-69

MISSISSIPPI  
BOARD OF WATER COMMISSIONERS  
416 North State Street  
Jackson, Mississippi 39201

WATER WELL DRILLERS LOG

7-17 1969 Ed J. Waterwell Serv. Pearl River  
date well completed firm name county well located

LANDOWNER:

Green  
Wheat Curve Highway  
(mailing address)

description of formations encountered

	from	to
Red Clay	0	5
Med. white sd.	5	28
Green Vert. Clay	28	45
Coarse white sd.		
2 C. sand	45	54

WELL LOCATION:

sec. 31 T. 5 N. R. 17 E.  
1 miles So. of Osprey  
(distance) (direction) (nearest town)

WELL PURPOSE:

Home  
(home, irrigation, municipal, industrial)

WELL COMPLETION DATA:

- (1) diameter (inches) 4 5/8
- (2) total depth (feet) 54
- (3) static water level (feet) 4 below top of ground.
- (4) casing Coke, 49,  
(material) (depth)  
2" if telescope see back.  
(size)
- (5) screen 5 49  
(length) (depth to top)  
2", 5. Steel  
(size) (material)
- (6) pump 1 500  
(HP) (yield gpm)  
Elect.  
(type power)
- (7) electric log NO  
(yes or no)
- (8) how well bottom plugged Shoe

NOV 21 1969


MISS. Bd. of  
WATER COMMISSIONERS

DRILLERS REMARKS:

Ed J. Waterwell Serv.

If well telescopes please sketch and show depths.

GROUND LEVEL

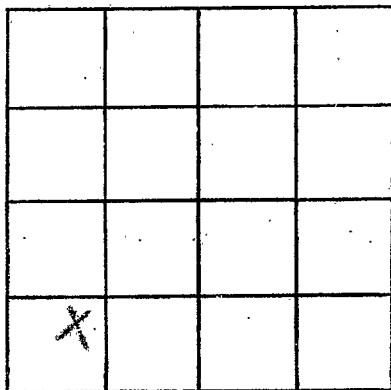

SECTION 31

Please indicate well location X.

ADDITIONAL INFORMATION

If more than one screen, show locations of each on sketch.