

PEARL RIVER  
U 11  
10-25-69

MISSISSIPPI  
BOARD OF WATER COMMISSIONERS  
416 North State Street  
Jackson, Mississippi 39201

CODED

WATER WELL DRILLERS LOG

NEIL LUMPKIN WELL DRILLING SERVICE

P. O. BOX 117

CARRIERE, MISS.  
firm name

*Pearl River*  
county well located

10-25 1969  
date well completed

LANDOWNER: *Phil Watkins*

description of formations encountered

from to

*Carrier Route*  
(mailing address)

*Surface clay* 0 20

WELL LOCATION:  
sec. 26 T. 5 S. R. 17 E. W. 4  
4 miles South of *Carrier*  
(distance) (direction) (nearest town)

" *sand (good)* 20 150

*Blue clay* 150 190

*fine to good sand* 190 237

WELL PURPOSE: *home*  
(home, irrigation, municipal, industrial)

WELL COMPLETION DATA:

(1) diameter (inches) 2"

(2) total depth (feet) 237

(3) static water level (feet) 84 below above top of ground.

(4) casing galv. (material) (depth)

2" (size) if telescope see back.

(5) screen 5' (length) (depth to top)

(size) St. Steel (material)

(6) pump 1 (HP) 500 gpm (yield gpm)

electric (type power)

(7) electric log No. (yes or no)

(organization running log)

(8) how well bottom plugged Johnson  
R.P. Valve


DRILLERS REMARKS:

NOV 10 1969

Miss. Bd. of  
Water Comm.

If well telescopes please sketch and show depths.

GROUND LEVEL

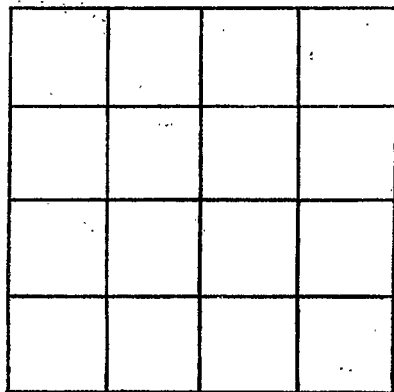

SECTION \_\_\_\_\_

Please indicate well location X.

ADDITIONAL INFORMATION

If more than one screen,  
show locations of each on sketch.