

PEARL RIVER
 Well 12
 8-11-69

MISSISSIPPI
 BOARD OF WATER COMMISSIONERS
 416 North State Street
 Jackson, Mississippi 39201

CODED
 CODED

WATER WELL DRILLERS LOG

NEIL LUMPKIN WELL DRILLING SERVICE
 P. O. BOX 117
 CARRIERS, MISS.

Pearl River
 county well located

8-11 1969
 date well completed

LANDOWNER: A. V. Smith
Rock Ranch Road
Carrriere, Miss.
 (mailing address)

description of formations encountered	from	to
Surface Clay	0	20
" Sand (no good)	20	44
Blue Clay	44	160
Good Sand	160	195

WELL LOCATION:
 sec. 8 T. 5 S. R. 15 E.
6 miles West of Carrriere
 (distance) (direction) (nearest town)

WELL PURPOSE: home
 (home, irrigation, municipal, industrial)

WELL COMPLETION DATA:

(1) diameter (inches) 2"

(2) total depth (feet) 195

(3) static water level (feet) 57 below above top of ground.

(4) casing galv. 190
 (material) (depth)
2" if telescope see back.
 (size)

(5) screen 5'
 (length) (depth to top)
2" St. Steel
 (size) (material)

(6) pump 1 450 per hr.
 (HP) (yield gpm)
electric
 (type power)

(7) electric log No.
 (yes or no)

(organization running log)

~~12-14-69~~
 JW
 OK

NOV 10 1969

MISS. BD. OF
 WATER COMM.


(8) how well bottom plugged
Johnson P. Valve

DRILLERS REMARKS:

MISS. BD. OF
 WATER COMM.

If well telescopes please sketch and show depths.

GROUND LEVEL

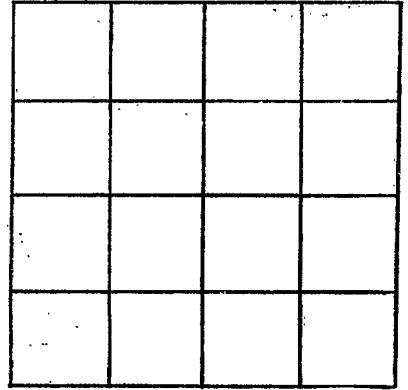

SECTION _____

Please indicate well location X.

ADDITIONAL INFORMATION

If more than one screen, show locations of each on sketch.