

Pearl River  
U 13  
1-14-70

MISSISSIPPI  
 BOARD OF WATER COMMISSIONERS  
 416 North State Street  
 Jackson, Mississippi 39201

CODED  
 CODED

WATER WELL DRILLERS LOG

1-14- 1970 Neil Lumpkin Wells Pearl River  
 date well completed firm name SERVICE county well located

LANDOWNER: Charles Knapp  
Picayune, Miss.  
 Hwy # 43  
 (mailing address)

description of formations encountered	from	to
<u>surface clay</u>	<u>0</u>	<u>20</u>
<u>surface sand</u>	<u>20</u>	<u>80</u>
<u>Blue Clay</u>	<u>80</u>	<u>250</u>
<u>Good grey sand - fine to better some gravel</u>	<u>250</u>	<u>385</u>
<u>Blue Clay</u>	<u>385</u>	<u>650</u>
<u>Grey sand, fine to good</u>	<u>650</u>	<u>735</u>

WELL LOCATION:  
 sec. 31 T. 5 S. R. 17  
8 miles NE of Picayune  
 (distance) (direction) (nearest town)

WELL PURPOSE: Home  
 (home, irrigation, municipal, industrial)

WELL COMPLETION DATA:

(1) diameter (inches) 2

(2) total depth (feet) 735

(3) static water level (feet) 24' below above top of ground.

(4) casing galv. (material) (depth) 714'  
2" if telescope see back. (size)

(5) screen 20' (length) (depth to top)  
7" (size) (material)

(6) pump (HP) (yield gpm)  
 (type power)

(7) electric log No. (yes or no)  
 (organization running log)

(8) how well bottom plugged Johnson back pressure valve


DRILLERS REMARKS: 12 lbs. pressure

JAN 21 1970

Price - 50¢  
 WATER

If well telescopes please sketch and show depths.

GROUND LEVEL

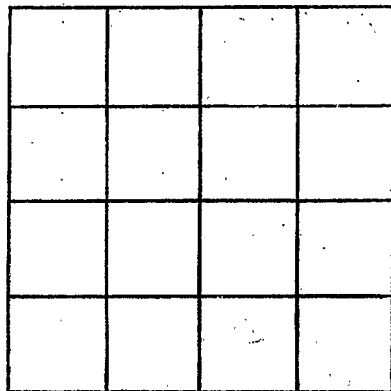

SECTION 31

Please indicate well location X.

ADDITIONAL INFORMATION

If more than one screen,  
show locations of each on sketch.