

Pearl River  
U 76  
5-6-70

MISSISSIPPI  
 BOARD OF WATER COMMISSIONERS  
 416 North State Street  
 Jackson, Mississippi. 39201

WATER WELL DRILLERS LOG

5-6  
 date well completed

NEIL LUMPKIN WELL DRILLING SERVICE  
 P.O. BOX 117  
 CARRIER, MISS.

Pearl River  
 county well located

LANDOWNER: H. W. Harbeson

description of formations encountered

from to

Carrier, Miss.

Surface Clay

0 15

(mailing address)

v sand

15 70

WELL LOCATION:

sec. 13 T 5 R 17 E 074

blue clay & shale

70 390

3/4 miles E of Carrier  
 (distance) (direction) (nearest town)

fine to perfect sand

390 430

WELL PURPOSE: home  
 (home, irrigation, municipal, industrial)

WELL COMPLETION DATA:

- (1) diameter (inches) 2"
- (2) total depth (feet) 430
- (3) static water level (feet) 60 below top of ground.
- (4) casing galv.  
 (material) (depth)  
2" if telescope see back.  
 (size)
- (5) screen 5'  
 (length) (depth to top)  
2" St. Steel  
 (size) (material)
- (6) pump 1 650 gph  
 (HP) (yield gpm)
- electric  
 (type power)
- (7) electric log no  
 (yes or no)

(organization running log)

(8) how well bottom plugged Johnson  
B.P. Valve


DRILLERS REMARKS:

JUN 1 1970

MISS. BD. OF  
 WATER COM.

If well telescopes please sketch and show depths.

GROUND LEVEL

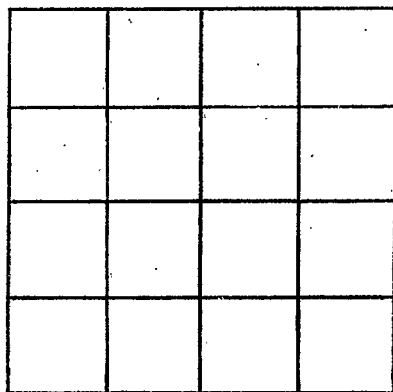

SECTION \_\_\_\_\_

Please indicate well location X.

ADDITIONAL INFORMATION

If more than one screen,  
show locations of each on sketch.