

Pearl River
U 17
5-5-70

MISSISSIPPI
 BOARD OF WATER COMMISSIONERS
 416 North State Street
 Jackson, Mississippi 39201

3 AA WATER WELL DRILLERS LOG

5-5 19 70 Penton Well Serv Pearl River
 date well completed firm name county well located

LANDOWNER: W.D. Thompson

Rt. 2 Box 271
Picayune Miss
 (mailing address)

description of formations encountered

from to

Surface Clay	0	26
Sand	26	28
White clay	28	35
Blue Clay	35	105
Grey sand	105	131

WELL LOCATION:

sec. 27.5 R 17 159
2 miles West of Oxoniz
 (distance) (direction) (nearest town)

WELL PURPOSE: Home
 (home, irrigation, municipal, industrial)

WELL COMPLETION DATA:

- (1) diameter (inches) 2
- (2) total depth (feet) 131
- (3) static water level (feet) 49 ~~49~~ below top of ground.
- (4) casing Galv, 126,
 (material) (depth)
2 if telescope see back.
 (size)
- (5) screen 5', 126
 (length) (depth to top)
2", S. Steel
 (size) (material)
- (6) pump 1/2, 8
 (HP) (yield gpm)
Elec
 (type power)
- (7) electric log NO
 (yes or no)

(organization running log)

(8) how well bottom plugged B.W. Valve


JUN 5 1970

MISS. BD. OF
 WATER COM.

DRILLERS REMARKS:

If well telescopes please sketch and show depths.

GROUND LEVEL

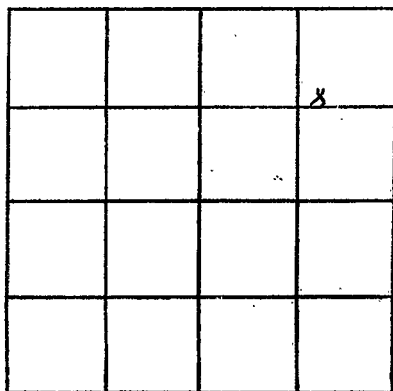

SECTION 27

Please indicate well location X.

ADDITIONAL INFORMATION

If more than one screen, show locations of each on sketch.