

ELOG #99

PEARL RIVER
W18
3-71

MISSISSIPPI
BOARD OF WATER COMMISSIONERS
416 North State Street
Jackson, Mississippi 39201

CODED

WATER WELL DRILLERS LOG

March 19 71 Lariver Drilling Serv, Inc Pearl River
date well completed firm name county well located

LANDOWNER: Hide-Away
lake, Inc.
Picayune, Miss
(mailing address)

WELL LOCATION:
sec. 36 T. 5 N R. 17 E
2 miles N of Picayune
(distance) (direction) (nearest town)

WELL PURPOSE: Municipal
(home, irrigation, municipal, industrial)

WELL COMPLETION DATA:

- (1) diameter (inches) 8"
- (2) total depth (feet) 1000'
- (3) static water level (feet) 14' below top of ground.
- (4) casing Steel 950'
(material) (depth)
8" if telescope see back.
(size)
- (5) screen 40' 960'
(length) (depth to top)
6" 304 SS.
(size) (material)
- (6) pump 20 250
(HP) (yield gpm)
Elec
(type power)
- (7) electric log Yes
(yes or no)
M L S
(organization running log)
- (8) how well bottom plugged Back
Wash Valve

description of formations encountered	depth	
	from	to
Top Soil	0	2
Clay	2	143
SAND	143	250
Clay	250	325
SAND	325	362
Clay	362	518
SAND	518	596
Clay	596	655
SAND	655	760
Clay	760	794
SAND	794	820
Clay	820	860
SAND	860	1126

CODED

MAR 5 - 1971


MRS. BD. OF
WATER COMM.

DRILLERS REMARKS:

8

If well telescopes please sketch and show depths.

GROUND LEVEL

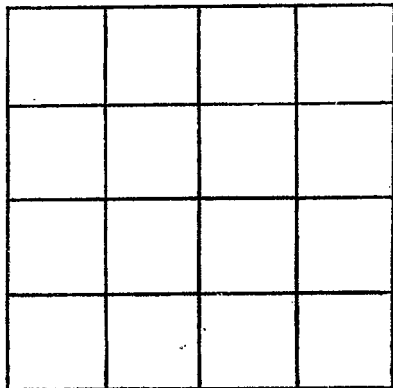

SECTION _____

Please indicate well location X.

ADDITIONAL INFORMATION

If more than one screen,
show locations of each on sketch.