

MISSISSIPPI  
BOARD OF WATER COMMISSIONERS  
416 North State Street  
Jackson, Mississippi 39201

**CODED**

WATER WELL DRILLERS LOG

PEARL RIVER  
U 21  
3-23-71

3-23 1971 Bud Penton & Son Pearl River  
date well completed firm name county well located

LANDOWNER: Jewel Penton & Son  
Renton,  
Carrine, Miss.  
(mailing address)

description of formations	from	to
<u>Red Shale</u>	<u>0</u>	<u>12</u>
<u>White sand</u>	<u>12</u>	<u>21</u>
<u>White Shale</u>	<u>21</u>	<u>36</u>
<u>" Sand</u>	<u>36</u>	<u>83</u>
<u>Blng. Shale</u>	<u>83</u>	<u>126</u>
<u>" Sand fine</u>	<u>126</u>	<u>148</u>
<u>Blue Shale</u>	<u>148</u>	<u>202</u>
<u>" Sand</u>	<u>202</u>	<u>266</u>

WELL LOCATION:  
sec. 11 T. 5 S. R. 17 W.  
2 miles W of Carrine  
(distance) (direction) (nearest town)

WELL PURPOSE: Home  
(home, irrigation, municipal, industrial)

- WELL COMPLETION DATA:
- (1) diameter (inches) 4 in
  - (2) total depth (feet) 266
  - (3) static water level (feet) 63 below above top of ground.
  - (4) casing PVC 256  
(material) (depth)
  - (5) screen 10 ft 256  
(size) (length) (depth to top)  
4 in PVC  
(size) (material)
  - (6) pump 1/2 3000 gpm  
(HP) (yield gpm)  
electric  
(type power)
  - (7) electric log NO  
(yes or no)
  - (8) how well bottom plugged Back  
Wash valve

**CODED**

APR 23 1971

MISS. DIV. OF  
WATER COMME.

DRILLERS REMARKS:


If well telescopes please sketch and show depths.

*Handwritten notes and numbers at the top of the page, including '15' and '25-5'.*

GROUND LEVEL

*Vertical list of handwritten numbers on the left side of the well diagram, including 5, 15, 20, 25, 30, 35, 40, 45, 50, 55, 60, 65, 70, 75, 80, 85, 90, 95, 100.*

*Handwritten notes and sketches describing well components and depths, including terms like 'Well', 'Screen', and 'Telescope'.*

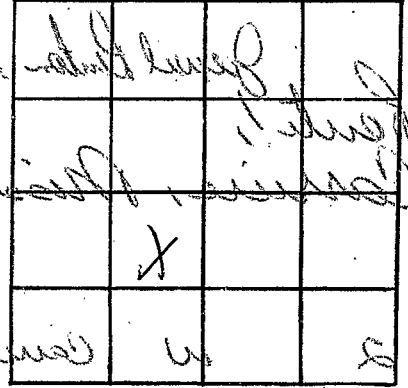

SECTION \_\_\_\_\_

Please indicate well location X.

ADDITIONAL INFORMATION

*Handwritten notes and sketches in the 'ADDITIONAL INFORMATION' section, including terms like 'Well', 'Screen', and 'Telescope'.*

If more than one screen, show locations of each on sketch.