

PEARL RIVER
U 22
2-24-71

MISSISSIPPI
 BOARD OF WATER COMMISSIONERS
 416 North State Street
 Jackson, Mississippi 39201

CODED

WATER WELL DRILLERS LOG

2-24 1971 Est water well serv. Pearl River
 date well completed firm name county well located

LANDOWNER:
Frank Spiers
Ozona Miss.
 (mailing address)

WELL LOCATION:
 sec. 26 T. 5 N. R. 17 E.
1/4 miles NO. of Ozona
 (distance) (direction) (nearest town)

description of formations encountered	from	to
<u>Red Clay</u>	<u>0</u>	<u>14</u>
<u>Red & white coarse sd.</u>	<u>14</u>	<u>56'</u>

WELL PURPOSE: Home
 (home, irrigation, municipal, industrial)

WELL COMPLETION DATA:

(1) diameter (inches) 7 1/2

(2) total depth (feet) 56

(3) static water level (feet) 30 below top of ground.

(4) casing Plastic 51
 (material) (depth)
4" If telescope see back.
 (size)

(5) screen 5 51-56
 (length) (depth to top)
4" Plastic
 (size) (material)

(6) pump 1/2 500
 (HP) (yield gpm)
Elect
 (type power)

(7) electric log NO
 (yes or no)

CODED

(organization running log)

(8) how well bottom plugged Sloue


MAY 17 1971

MISS. BD. OF
 WATER COMMISSIONERS

DRILLERS REMARKS:

If well telescopes please sketch and show depths.

GROUND LEVEL

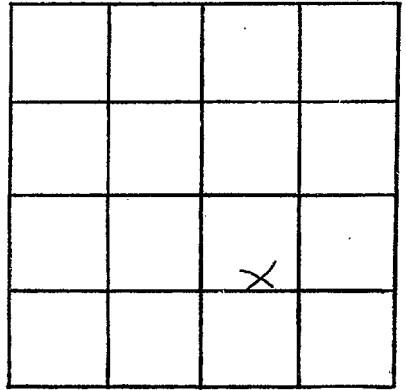

SECTION 26

Please indicate well location X.

ADDITIONAL INFORMATION

If more than one screen,
show locations of each on sketch.