

PEARL RIVER
 U 23
 5-18-71

MISSISSIPPI
 BOARD OF WATER COMMISSIONERS
 416 North State Street
 Jackson, Mississippi 39201

CODED

WATER WELL DRILLERS LOG

5-18 date well completed
 1971 Penlon Well Serv Pearl River firm name county well located

LANDOWNERS	description of formations encountered	from	to
Joseph Bennette Rt. 4	Surface Clay	0	26
Picayune Miss. (mailing address)	Sand	26	60
	Blue Clay	60	260
	Sand	260	299

WELL LOCATION:
 sec. 28 T 5 S R 17 E
 3 miles North of Picayune
 (distance) (direction) (nearest town)

WELL PURPOSE: Home
 (home, irrigation, municipal, industrial)

- WELL COMPLETION DATA:
- (1) diameter (inches) 2
 - (2) total depth (feet) 299
 - (3) static water level (feet) 27 below top of ground.
 - (4) casing Galv. 294 (material) (depth)
 2 (size) if telescope see back.
 - (5) screen 5 294 (length) (depth to top)
 2 S. steel (size) (material)
 - (6) pump 1/2 9 (HP) (yield gpm)
 Elec (type power)
 - (7) electric log NO (yes or no)
 - (organization running log)
 - (8) how well bottom plugged BU Value


CODED

DRILLERS REMARKS:

JUN 1 1971
 MISSISSIPPI
 BOARD OF WATER COMMISSIONERS

If well telescopes please sketch and show depths.

GROUND LEVEL

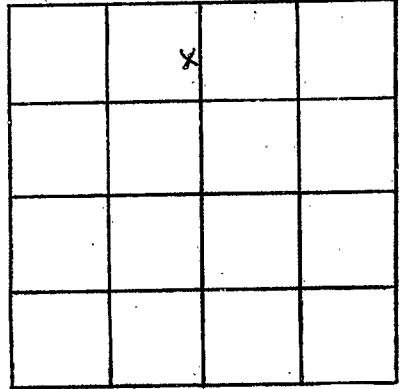

SECTION 28

Please indicate well location X.

ADDITIONAL INFORMATION

If more than one screen, show locations of each on sketch.