

Pearl River

U-25  
7-29-60

WATER WELL DRILLERS LOG

Date: July 29, 1960, Driller: M & B Drilling Co. Harrison

558-15 381-19

(Name)

**CODED**

- (1) Owner of Land: Mr. Welch  
(Name)  
Carrier, Miss.  
(Address)
- (2) Location: 1/4, 1/4, Sec. 13 T5 R12  
Center of Carrier  
miles of  
(distance) (direction) (Nearest Town)
- (3) Topography: Hilly  
(Hilly) (Flat) (Level)
- (4) Purpose of Well: Domestic  
(Domestic Irrigation  
Municipal, Industrial, Other)

Description & Color of Materials Sand, Clay, Red Clay, Shell, etc.	Thick- ness Feet	Depth Feet
Clay	15	15
Sand	10	25
White Clay	5	30
Sand	35	65
White Clay	15	80
Blue clay	47	127
Sand	12	140
Blue clay	47	187
Sand Break	2	189
Blue Clay	57	246
Sand	30	276

Information upon completion of well:


- (1) Diameter 2 inches.
- (2) Total Depth 268 feet.
- (3) Water Level 127 feet below top of ground.
- (4) Cased to 262, Size 2"
- (5) Screen: Size 8 slot, Length 6 FT.
- (6) Were any formations sealed against pollution?  
\_\_\_\_\_ yes, \_\_\_\_\_ no.

**CODED**

If YES depth of formation \_\_\_\_\_

Why \_\_\_\_\_

Drillers Remarks: \_\_\_\_\_

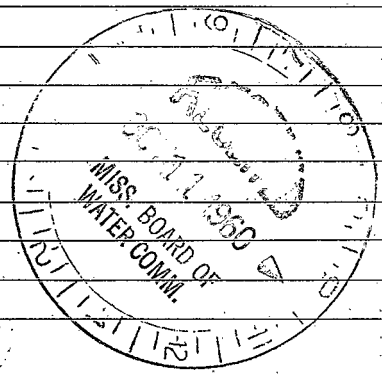

(Use Back Side)

Well No.

Handwritten text, possibly a list or notes, covering the top half of the page. The text is extremely faint and illegible.

Handwritten text, possibly a list or notes, covering the bottom half of the page. The text is extremely faint and illegible.