

U-26

11-1-60

WATER WELL DRILLERS LOG

W-308

Date: 11-1, 1960, Driller: Quick & Ericson P.R.

(Name)

CODED

(1) Owner of Land: Norman Kendrick
 (Name)
Picayune Miss.
 (Address)

(2) Location: 1/4, 1/4, Sec. 21 T5R17,
3 miles West of Picayune,
 (distance) (direction) (Nearest Town)

(3) Topography: X
 (Hilly) (Flat) (Level)

(4) Purpose of Well: Domestic
 (Domestic Irrigation, Municipal, Industrial, Other)

Description & Color of Materials Sand, Clay, Red Clay, Shell, etc.	Thick-ness Feet	Depth Feet
Clay	0	15
Sand	15	50
Clay	50	125
Sand	125	160
Clay	160	255
Sand	255	370
Clay	370	475
Sand	475	495
Clay	495	555
Sand	555	590
Clay	590	700
grd sand	700	780

Information upon completion of well:

(1) Diameter 2" inches.

(2) Total Depth 780 feet.

(3) Water Level _____ feet below top of ground.

(4) Cased to _____, Size _____.


(5) Screen: Size 2", Length 10'.

(6) Were any formations sealed against pollution?
 _____ yes, X no.

If YES depth of formation _____
 Why _____

Drillers Remarks: Good well.
20 lbs Pressure.
45 gal Per Minute.

CODED

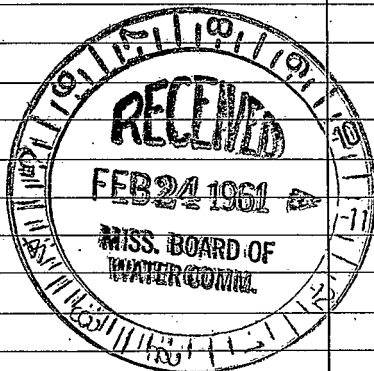

201

Well No.

(Use Back Side)

[The page contains extremely faint and illegible text, likely bleed-through from the reverse side of the document. No specific words or phrases can be discerned.]