

U-~~27~~ 27 WATER WELL DRILLERS LOG
1-16-62

Date: 1-16, 1962, Driller: Quick & Green, County P.R.
545-36 (Name)

CODED

(1) Owner of Land: Ernest Hanson
(Name)
Rt., Piquette, Miss.
(Address)

(2) Location: 1/4, 1/4, Sec 28 T5R17
3 miles N-W, of Piquette
(distance) (direction) (Nearest town)

(3) Topography: _____
(Hilly) (Flat) (Level)

(4) Purpose of Well: _____
(Domestic) (Irrigation) (Municipal, Industrial, Other)

Description & Color of Material Sand, Clay, Red Clay, Shell, etc.	Thick- ness Feet	Depth Feet
red clay	0	15
sand	15	55
blue clay	55	230
gray sand	230	340
blue clay	340	560
gray sand	560	609

Information upon completion of well:

(1) Diameter 2" inches.

(2) Total Depth 609 feet.

(3) Water Level: flowing feet below top of ground.

(4) Cased to _____, Size _____

(5) Screen: Size 2", Length 20'

(6) Were any formations sealed against pollution?
_____ yes, no.


If YES depth of formation _____

Why _____

Drillers Remarks: _____

609

CODED

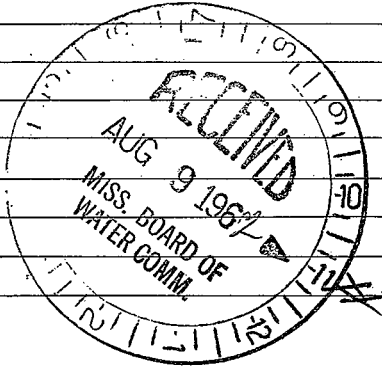


(Use Back Side)

20 Well No.

1912

...

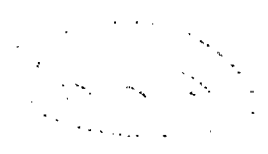

...

...

...