

Pearl R.
U-28
2-27-62

WATER WELL DRILLERS LOG

Date: Feb. 27, 1962, Driller: M & B Drilling Co. ^{Pearl River} County, Miss.
(Name)

CODED

James S. Smith, Kyle E. Terrell
(1) Owner of Land: Arnold F. Pearson
(Name)
Carrier, Miss.
(Address)
(2) Location: 1/4, 1/4, Sec. 13 T5 R17
South edge of Carrier
miles _____, of _____
(distance) (direction) (Nearest Town)
(3) Topography: Hilly
(Hilly) (Flat) (Level)
(4) Purpose of Well: Domestic for Chamber
(Domestic Irrigation
Municipal, Industrial, Other)


Description & Color of Materials Sand, Clay, Red Clay, Shell, etc.	Thick- ness Feet	Depth Feet
Red Clay	18	18
White Sand	57	75
White Clay & Sand Breaks	45	120
Hard White Clay	10	130
Blue Clay	40	170
Sand & Clay Breaks	18	188
White-Brownish Sand Layer	5	193
Clay Break	2	195
Coarse Gray Sand &		
Black Gravel	15	210
Blue Clay	8	218
Fine Gray Sand	37	255
Blue Clay	12	267
Medium Gray Sand	21	288
Blue Clay 288-		

Information upon completion of well:

(1) Diameter 2 inches.
(2) Total Depth 282 feet.
(3) Water Level 120 feet below top of ground.
(4) Cased to 293 FT., Size 2"
(5) Screen: Size 2" 8 slot, Length 10 FT.
(6) Were any formations sealed against pollution?
_____ yes, _____ no.

CODED

If YES depth of formation _____
Why _____
Drillers Remarks: _____

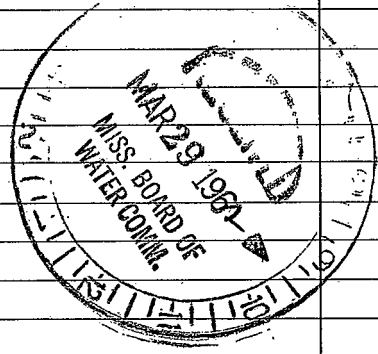

(Use Back Side)

Well No.

