


P.R.  
 U37  
 7/12/74

MISSISSIPPI  
 BOARD OF WATER COMMISSIONERS  
 416 North State Street  
 Jackson, Mississippi 39201

WATER WELL DRILLERS LOG

7-12 1974 date well completed  
 Josephine Well Ser. firm name  
 Paul River county well located


LANDOWNER:	description of formations encountered	from	to
Laran Hancock Carrine Miss (mailing address)			
<b>WELL LOCATION:</b> sec 26 T. 5 N. R. 17 E 1 miles East of Ozone (distance) (direction) (nearest town)			
<b>WELL PURPOSE:</b> Home (home, irrigation, municipal, industrial)			
<b>WELL COMPLETION DATA:</b> (1) diameter (inches) 2" (2) total depth (feet) 315 (3) static water level (feet) 60 below top of ground. (4) casing P.V.C. 310 (material) (depth) 2" (size) If telescope see back. (5) screen 51 310 (length) (depth to top) 2" P.V.C. (size) (material) (6) pump 1 300 (HP) (yield gpm) Elec- (type power) (7) electric log No (yes or no) (organization running log) (8) how well bottom plugged Sand Shale	CODED		
<b>DRILLERS REMARKS:</b>			

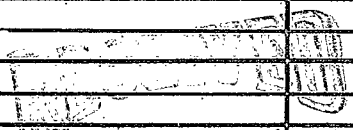

NOV - 9 1974

If well telescopes please sketch and show depths.

GROUND LEVEL

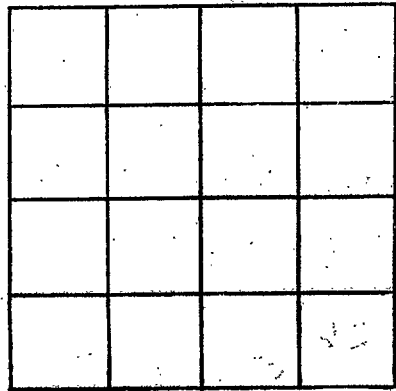

SECTION \_\_\_\_\_

Please indicate well location X.

ADDITIONAL INFORMATION

If more than one screen, show locations of each on sketch.