

Pearl River
 U 38
 4-3-69

MISSISSIPPI
 BOARD OF WATER COMMISSIONERS
 416 North State Street
 Jackson, Mississippi 39201

CODED

WATER WELL DRILLERS LOG

4-3 1969 E & J water well serv. Pearl River
 date well completed firm name county well located

LANDOWNER:

A.C. Tochay
 Rt 1 Carriere miss.
 (mailing address)

description of formations encountered

	from	to
white medium sand	0	18
Blue Clay	18	55
Clay & sand str.	55	65
Coarse Gray Sand	65	80

WELL LOCATION:

sec 10 T 5 N R 17 E
 3 miles west of Carriere
 (distance) (direction) (nearest town)

WELL PURPOSE:

Home
 (home, irrigation, municipal, industrial)

WELL COMPLETION DATA:

- (1) diameter (inches) 4 1/2"
- (2) total depth (feet) 80
- (3) static water level (feet) 9 below top of ground.
- (4) casing Calc. 80 (material) (depth)
- 2 (size) if telescope see back.
- (5) screen 5 75 (length) (depth to top)
- 2 (size) S. Steel (material)
- (6) pump 1/2 600 (HP) (yield gpm)
- Elect. Jet Pump. (type power)
- (7) electric log NO (yes or no)

(organization running log)

(8) how well bottom plugged shoe

DRILLERS REMARKS:


E.B. Kester

APR 14 1969

MISS. Bd. of WATER COMMISSIONERS

If well telescopes please sketch and show depths.

GROUND LEVEL

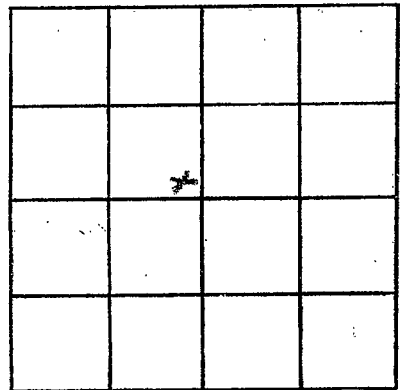

SECTION 10

Please indicate well location X.

ADDITIONAL INFORMATION

*Set 3 H.P. Set Pump
42 Gal Tank*

If more than one screen, show locations of each on sketch.